

SURVEY & REMONUMENTATION

OCT 24 1994

COMMISSION

**OTTAWA COUNTY REMONUMENTATION
LAND CORNER RECORDATION CERTIFICATE
Filing Requirement of Act 74, Mich. P.A. 1970**

RECORDED

94 OCT -7 PM 12:33

Randy D. Feenstra
REGISTER OF DEEDS
OTTAWA COUNTY, MI

For corners in

Ottawa

(County)

Located In:

Corner Code #

- | | | |
|------------------------------------|-------------------------|------------------|
| 1. Public Land Survey | T 6N R 14W | H-9, S 1/4 COR |
| | T _____ R _____ | Sec. 22, Blendon |
| | T _____ R _____ | _____ |
| | T _____ R _____ | _____ |
| 2. Property Controlling in Section | S _____ T _____ R _____ | _____ |
| | S _____ T _____ R _____ | _____ |
| 3. Miscellaneous Property in Sec. | S _____ T _____ R _____ | _____ |
| | S _____ T _____ R _____ | _____ |

Register of Deeds Stamp & File Number

4. Lot No. _____, Recorded Plat _____
5. Private Claims _____

	A	B	C	D	E	F	G	H	I	J	K	L	M
2	6		5		4		3		2		1		
3													
4	7		8		9		10		11		12		
5													
6	18		17		16		15		14		13		
7													
8	19		20		21		22		23		24		
9													
10	30		29		28		27		26		25		
11													
12	31		32		33		34		35		36		
13													

I, Randal D. Feenstra in a field survey on May 4, 1994, do hereby certify that under requirements of P.A. 74, Michigan P.A. of 1970, the corner points mentioned in lines 1 and 2 above were in conformance with regulations and rules therefore as required in the current manual of survey instructions of the United States Department of the Interior, Bureau of Land Management or by a decree of a Court of Law and/or that the corner points mentioned in lines 3, 4 and 5 above were in conformance with the rules of the Michigan Board of Land Surveyors or by a Decree of a Court of Law; established, re-established, monumented, re-monumented, recovered, found as expressed below:

NOTE: Not more than 4 corners, all in the same town and range, may be recorded on this certificate.

A. Description of original monument and accessories and/or subsequent restoration:

- | | | |
|----------------------|--------------------------------|--------------------------|
| L.O. (1832) POST | Liber 1, Page 761 (1972) | Liber 5, Page 120 (1984) |
| Elm N31.5°W 4.6' | IRON IN MONUMENT BOX | CAST IRON MONUMENT |
| Black Ash S64°E 7.9' | Nail in 12" Box Elder S 36.25' | Twin 7" Tree N 55.48' |
| Samuel Marrs | SE Cor. Hse. Fndn. NW 173.66' | 3" Tree NW 49.07' |
| | | 2" Poplar NW 63.99' |
| | | 2" Tree WNW 86.99' |

B. Description of corner evidence found and/or method applied in restoring or reestablishing corner:

Found: Cast Iron Monument in Monument Box—accepted as a careful and faithful perpetuation of the position of the original corner.

Found Witnesses:

- | | |
|--|-----------|
| Nail & Tag (NJ 21272) in E side 6" Box Elder | NW 48.95' |
| Spike in W side in 5" Poplar | NW 64.01' |


PA. 345 OTTAWA COUNTY

PEER APPROVED 8/22/94

Randy D. Feenstra

C. Description of monument for corner and accessories established to perpetuate locating the position of the corner:

- | | |
|--|--------------|
| H-9 Cast Iron Monument in Monument Box | |
| O.C. Remon. Nail & Tag in SW side PP | N40°E 43.22' |
| O.C. Remon. Nail & Tag in W side 6" Box Elder | N30°W 49.17' |
| O.C. Remon. Nail & Tag in NE side 5" Poplar | N60°W 63.91' |
| O.C. Remon. Nail & Tag in W side Twin 8" Box Elder | N00°E 33.22' |
| On CL Port Sheldon, E edge of woods to North. | |

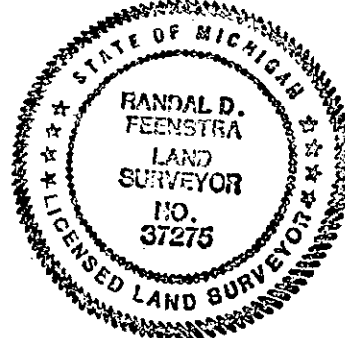

Signed by

Randal D. Feenstra

Date

May 4, 1994

Surveyor's Michigan License No. 37275