

**SURVEY &  
REMONUMENTATION**

APR 05 1996

**OTTAWA COUNTY REMONUMENTATION  
LAND CORNER RECORDATION CERTIFICATE  
Filing Requirement of Act 74, Mich. P.A. 1970**

For corner of **COMMISSION**

Ottawa (County)	Located In:	Corner Code #
	Blendon Twp.	H-11, N 1/4 cor.
1. Public Land Survey	T <u>6N</u> R <u>14W</u>	Sec. 34
	T _____ R _____	_____
	T _____ R _____	_____
	T _____ R _____	_____
2. Property Controlling in Section	S _____ T _____ R _____	_____
	S _____ T _____ R _____	_____
3. Miscellaneous Property in Sec.	S _____ T _____ R _____	_____
	S _____ T _____ R _____	_____

**RECORDED**

95 NOV 29 PH 1:43

*Rhonda K. Redwood*  
REGISTER OF DEEDS  
OTTAWA COUNTY, MI

Register of Deeds Stamp & File Number

4. Lot No. \_\_\_\_\_, Recorded Plat \_\_\_\_\_  
5. Private Claims \_\_\_\_\_

A	B	C	D	E	F	G	H	I	J	K	L	M
2	6	5	4	3	2	1						
3												
4	7	8	9	10	11	12						
5												
6	18	17	16	15	14	13						
7												
8	19	20	21	22	23	24						
9												
10	30	29	28	27	26	25						
11												
12	31	32	33	34	35	36						

I, Randal D. Feenstra, in a field survey on November 6, 1995, do hereby certify that under requirements of P.A. 74, Michigan P.A. of 1970, the corner points mentioned in lines 1 and 2 above were in conformance with regulations and rules therefore as required in the current manual of survey instructions of the United States Department of the Interior, Bureau of Land Management or by a decree of a Court of Law and/or that the corner points mentioned in lines 3, 4 and 5 above were in conformance with the rules of the Michigan Board of Land Surveyors or by a Decree of a Court of Law; established, re-established, monumented, re-monumented, recovered, found as expressed below:

**NOTE: Not more than 4 corners, all in the same town and range, may be recorded on this certificate.**

**A. Description of original monument and accessories and/or subsequent restoration:**

G.L.O. (1832) Calvin Britain 3" Beech S16°W 5 lks. 18" Beech N25°E 24 lks.	LIBER 2, PAGE 363 (1973) *X on stone Nail in 16" Oak. ESE 44.1' Nail in 18" Pine ESE 91.60' Nail in 18" Oak NW 21.78'	LIBER 2, PAGE 687 (1974) C.I.M. 18" Pine ESE 91.57' 18" Oak N 21.85' 15" Sycamore WNW 99.11' 16" Oak ESE 44.04'	LIBER 3, PAGE 25 (1974) C.I.M. 18" Oak NNW 21.85' 18" Pine ESE 91.57' 16" Oak ESE 44.04' 15" Sycamore WNW 99.11'
---	---	--	---

**B. Description of corner evidence found and/or method applied in restoring or reestablishing corner:**

Found: C.I.M. Accepted as a careful and faithful perpetuation of the position of the original corner.

Nail and Tag in S. side 24" Pine ENE 91.52'  
Nail and Tag in S side 24" Oak ESE 43.97'


P.A. 345 OTTAWA COUNTY  
PEER APPROVED 11/20/95

*Rhonda K. Redwood*  
MON

**C. Description of monument for corner and accessories established to perpetuate locating the position of the corner:**

H-11 C.I.M. in gravel	
Ottawa County Remon. Nail & Tag in N side 24" Pine	105° 91.53'
Ottawa County Remon. Nail & Tag in N side 24" Oak	113° 43.97'
Ottawa County Remon. Nail & Tag in W side P. Pole	25° 39.28'
Ottawa County Remon. Nail & Tag in S side 14" Oak	80° 136.80'

On centerline Van Buren

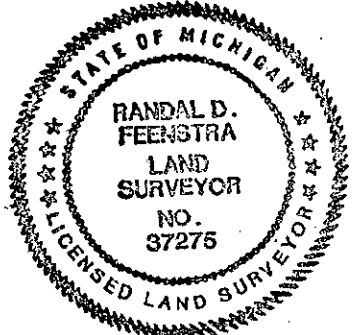

Signed by Randal D. Feenstra

Date November 6, 1995

Surveyor's Michigan License No. 37275