

FEB 24 2000

OTTAWA COUNTY REMONUMENTATION
LAND CORNER RECORDATION CERTIFICATE
Filing Requirement of Act 74, Mich. P.A. 1970

RECORDED

99 SEP 23 PM 3: 20

For corners in SECTION

OTTAWA
(County)

Located In: Corner Code #
BLENDON TOWNSHIP

- 1. Public Land Survey T. 6N R. 14W H-13
T. R. S 1/4 Corner
T. R. Section 34
T. R.
- 2. Property Controlling S. T. R.
in Section S. T. R.
- 3. Miscellaneous S. T. R.
Property In Sec. S. T. R.

Darryl Schallert
REGISTER OF DEEDS
OTTAWA COUNTY, MI

Register of Deeds Stamp & File
Number

- 4. Lot No. _____, Recorded Plat _____
- 5. Private Claims _____

I, Rodney D. Unema, in a field survey on September 16, 19 99 do hereby state that under requirements of P.A. 74, Michigan P.A. of 1970, the corner points mentioned in lines 1 and 2 above were in conformance with regulations and rules therefore as required in the current manual of survey instructions of the United States Department of the Interior, Bureau of Land Management or by a decree of a Court of Law and for that the corner points mentioned in lines 3, 4 and 5 above were in conformance with the rules of the Michigan Board of Land Surveyors or by a Decree of a Court of Law; established, re-established, monumented, recovered, found as expressed below:

NOTE: Not more than 2 corners, all in the same town and range, may be recorded on this certificate.

	A	B	C	D	E	F	G	H	I	J	K	L	M
1													
2	6		5		4		3		2		1		
3													
4	7		8		9		10		11		12		
5													
6	18		17		16		15		14		13		
7													
8	19		20		21		22		23		24		
9													
10	30		29		28		27		26		25		
11													
12	31		32		33		34		35		36		
13													

A. Description of original monument and accessories and/or subsequent restoration:

H-13 S 1/4 Corner, Section 34

Nov. 1831, G.L.O. Survey by Sylvester Sibley Set H.W.P. 18" Beech N62°W 8 links 6" Sugar N78°E 54 links	Aug. 6, 1973 (Englert) Liber 2, Page 245 Found Stone & "T" Iron T.P. North 32.10' 20" Oak SE 38.50' 24" Maple SW 63.60'	Nov. 15, 1973 Liber 2, page 365 Found "T" Iron Nail in P. pole NNE 32.14' Nail in 20" Oak SE 38.56' Nail in 16" Oak SW 63.88'
--	--	--

B. Description of corner evidence found and/or method applied in restoring or reestablishing corner:

H-13 Found "T" Iron along side Stone in Gravel Road


H-1 T5N, R14W, "T" Iron	N90°W	41.50'
Fnd nail in East side 24" Maple	S57°W	63.25'
Fnd nail in Northerly side 24" Maple	S57°W	63.80'
"T" Iron is on Tree ROW to North		

Accepted "T" Iron as a careful and faithful perpetuation of the position of the original corner, and replaced with standard Ottawa County Cap on 3/4" x 24" Steel Bar.

9/20/99
RDU

C. Description of monument for corner and accessories established to perpetuate locating the position of the corner:

H-13 Ottawa County Cap on 3/4" x 24" Bar in Gravel Road (New Holland Street) Top of Cap is 8" below gravel surface.		
Set nail & O.C. remon tag in W. side 4" Hickory	N5°E	66.80'
Set nail & O.C. remon tag in N. side 24" Maple	S57°W	63.78'
Set nail & O.C. remon tag in SE side 10" Maple	S24°W	43.99'
Set nail & O.C. remon tag in NE side 6" Oak	S60°E	68.45'
H-1 T5N, R14W, O.C. mon.	N90°W	41.50'
Centerline of E-W gravel road	South	+/- 1'

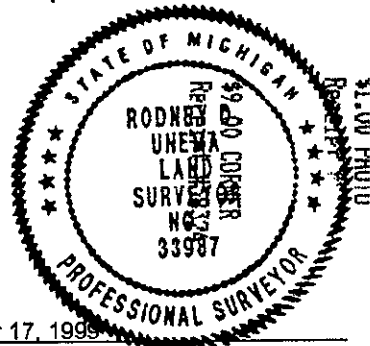

Signed by Rodney D. Unema
Surveyor's Michigan License No. 33987

Date September 17, 1999