

SURVEY &  
REMONUMENTATION

OCT 24 1994

COMMISSION

OTTAWA COUNTY REMONUMENTATION  
LAND CORNER RECORDATION CERTIFICATE  
Filing Requirement of Act 74, Mich. P.A. 1970

RECORDED

94 OCT -7 PM 12:34

*Ralph A. Robinson*  
REGISTER OF DEEDS  
OTTAWA COUNTY, MI

For corners in

Ottawa (County)	Located In:	Corner Code #
1. Public Land Survey	T 6N R 14W	I-3 NW COR Sec. 11 Btendon
	T R	
	T R	
	T R	
2. Property Controlling in Section	S T R	
	S T R	
3. Miscellaneous Property in Sec.	S T R	
	S T R	
4. Lot No. _____, Recorded Plat _____		
5. Private Claims _____		

Register of Deeds Stamp & File Number

I, Randal D. Feenstra in a field survey on May 26, 19 94, do hereby certify that under requirements of P.A. 74, Michigan P.A. of 1970, the corner points mentioned in lines 1 and 2 above were in conformance with regulations and rules therefore as required in the current manual of survey instructions of the United States Department of the Interior, Bureau of Land Management or by a decree of a Court of Law and/or that the corner points mentioned in lines 3, 4 and 5 above were in conformance with the rules of the Michigan Board of Land Surveyors or by a Decree of a Court of Law, established, re-established, monumented, re-monumented, recovered, found as expressed below:

**NOTE: Not more than 4 corners, all in the same town and range, may be recorded on this certificate.**

A. Description of original monument and accessories and/or subsequent restoration:

GLO (1838)	Liber 2, Page 125 (1973)	Liber 4, Page 131 (1980)
12" Tamarack N19°W 32.3	1" PIPE	C.I.M.
6" Birch S60°W 40.9	PP NW 38.80	Nail in Fence Post SW 32.39
POST	PP NE 77.55	Underground Tele Sign NW 43.53
Samuel Marrs	PP SW 32.30	Twin 7" Maple SE 48.96
		PP NE 77.77

B. Description of corner evidence found and/or method applied in restoring or reestablishing corner:

Found: Cast Iron Monument - accepted as a careful and faithful perpetuation of the position of the original corner.  
Found Witnesses:  
Underground Tele Sign N60°W 43.21  
Nail SW side 12" Twin Maple S45°E 48.98'


PA. 345 OTTAWA COUNTY

PEER APPROVED 8/22/94

*Randal D. Feenstra*

C. Description of monument for corner and accessories established to perpetuate locating the position of the corner:

I-3 Cast Iron Monument		
O.C. Remon. Nail & tag NW side PP	N45°E	75.91'
O.C. Remon. Nail & tag E side Fence Post	N40°W	44.17'
O.C. Remon. Nail & tag W side 12" Maple	S20°W	27.95'
O.C. Remon. Nail & tag N side 8" Elm	S45°E	37.22'
4' North of Taylor CL and 2' East of 64th CL		

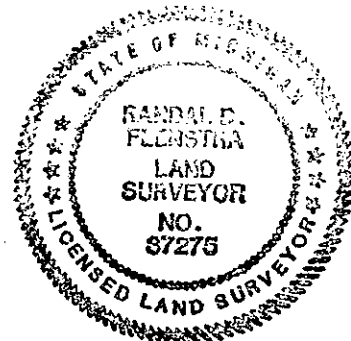

Signed by Randal D. Feenstra

Date May 26, 1994

Surveyor's Michigan License No. 37275