

OCT 24 1994

COMMISSION

OTTAWA COUNTY REMONUMENTATION

LAND CORNER RECORDATION CERTIFICATE

Filing Requirement of Act 74, Mich. P.A. 1970

RECORDED

OCT -7 PH 12:33


For corners in

REGISTER OF DEEDS
OTTAWA COUNTY, MI

Ottawa (County)	Located In:	Corner Code #
1. Public Land Survey	T 6N R 14W	I-5 SW COR Sec. 11, Blendon
	T _____ R _____	_____
	T _____ R _____	_____
	T _____ R _____	_____
2. Property Controlling in Section	S _____ T _____ R _____	_____
	S _____ T _____ R _____	_____
3. Miscellaneous Property in Sec.	S _____ T _____ R _____	_____
	S _____ T _____ R _____	_____
4. Lot No. _____, Recorded Plat _____		
5. Private Claims _____		

Register of Deeds Stamp & File Number

I, Randal D. Feenstra in a field survey on May 26, 1994, do hereby certify that under requirements of P.A. 74, Michigan P.A. of 1970, the corner points mentioned in lines 1 and 2 above were in conformance with regulations and rules therefore as required in the current manual of survey instructions of the United States Department of the Interior, Bureau of Land Management or by a decree of a Court of Law and/or that the corner points mentioned in lines 3, 4 and 5 above were in conformance with the rules of the Michigan Board of Land Surveyors or by a Decree of a Court of Law; established, re-established, monumented, re-monumented, recovered, found as expressed below:

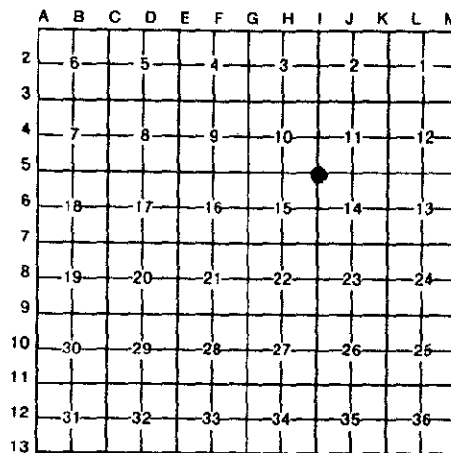

NOTE: Not more than 4 corners, all in the same town and range, may be recorded on this certificate.

A. Description of original monument and accessories and/or subsequent restoration:

0 (1838)	Liber 2, Page 757 (1975)	Liber 4, Page 349 (1982)
Maple S12°E 8.6	1" Pipe	C.I.M.
Beech N89°W 13.9	12" Maple SW 22.10	12" Maple SW 22.20
ST	PP NE 93.35	10" Maple WSW 79.90
uel Marrs	PP NW 109.86	PP ESE 288.78

ber 5, Page 161 (1984)
I.M.; 15" Maple SW 22.17; 12" Maple WSW 79.95; PP ESE 288.80

B. Description of corner evidence found and/or method applied in restoring or reestablishing corner:

Found C.I.M. - accepted as a careful and faithful perpetuation of the position of the original corner.
Found Witnesses:
Pk Nail N side PP S65°W 288.80

P.A. 345 OTTAWA COUNTY
PEER APPROVED 8/22/94
Randy P. Newell

C. Description of monument for corner and accessories established to perpetuate locating the position of the corner:

I-5 Cast Iron Monument		
O.C. Remon. Nail & tag E side wood sign post		N 63.56'
O.C. Remon. Nail & tag W side 24" Maple	S25°W	22.21'
O.C. Remon. Nail & tag N side 24" Maple	S75°W	109.66'
Chisled x in 12" e end conc. culvert	S60°W	51.59'
CL Polk Avenue		



Signed by Randal D. Feenstra Date May 26, 1994

Surveyor's Michigan License No. 37275