

SURVEY & REMONUMENTATION

OCT 24 1994

OTTAWA COUNTY REMONUMENTATION

RECORDED

LAND CORNER RECORDATION CERTIFICATE

94 OCT -7 PM 12:33

COMMISSION

Filing Requirement of Act 74, Mich. P.A. 1970

For corners in

Ottawa

(County)

Located In:

Corner Code #

1. Public Land Survey	T 6N R 14W	I-8, E 1/4 COR
	T ___ R ___	Sec. 22, Blendon
	T ___ R ___	
	T ___ R ___	
2. Property Controlling in Section	S ___ T ___ R ___	
	S ___ T ___ R ___	
3. Miscellaneous Property in Sec.	S ___ T ___ R ___	
	S ___ T ___ R ___	

Robert A. ...
REGISTER OF DEEDS
OTTAWA COUNTY, MI

Register of Deeds Stamp & File Number

4. Lot No. _____, Recorded Plat _____
5. Private Claims _____

A	B	C	D	E	F	G	H	I	J	K	L	M
2	6	5	4	3	2							
3												
4	7	8	9	10	11	12						
5												
6	18	17	16	15	14	13						
7												
8	19	20	21	22	23	24						
9												
10	30	29	28	27	26	25						
11												
12	31	32	33	34	35	36						
13												

I, Randal D. Feenstra in a field survey on May 4, 19 94, do hereby certify that under requirements of P.A. 74, Michigan P.A. of 1970, the corner points mentioned in lines 1 and 2 above were in conformance with regulations and rules therefore as required in the current manual of survey instructions of the United States Department of the Interior, Bureau of Land Management or by a decree of a Court of Law and/or that the corner points mentioned in lines 3, 4 and 5 above were in conformance with the rules of the Michigan Board of Land Surveyors or by a Decree of a Court of Law; established, re-established, monumented, re-monumented, recovered, found as expressed below:

NOTE: Not more than 4 corners, all in the same town and range, may be recorded on this certificate.

A. Description of original monument and accessories and/or subsequent restoration:

..O. (1832) Liber 1, Page 409 (1972) Liber 2, Page 329 (1973)
ST
Black Ash N6.5°E 4.0' STEEL BAR 1/2" ROD
Birch S83°W 4.6' 18" Sycamore SW 40.66 Nail in 18" Sycamore SW 41.29
Juel Marrs Tele. Pole NW 60.28 Nail in 16" Maple NNE 67.69
ber 5, Page 121 (1984) Trans. Pole E 101.30 Nail in 14" Catalpa NW 53.63
t Iron Mon. 18" Maple 66.60 CL St. Sign Post E 21.93
St. Sign E 21.93 St. Sign ESE 21.89
Sycamore SW 41.29; 15" Catalpa NW 53.41; 22" Sycamore NE 55.07

3. Description of corner evidence found and/or method applied in restoring or reestablishing corner:

Found: Cast Iron monument - accepted as a careful and faithful perpetuation of the position of the original corner.


Found Witnesses:

Nail & Tag in S side PP	NW 60.28'
Nail & Tag in SW side 18" Maple	NE 66.69'
CL Street Sign Post	E 21.93'
Nail & Tag in NE side 16" Sycamore	SW 40.47'
Spike in SE side 16" Sycamore	SW 41.25'
Spike in NW side 16" Sycamore	SW 40.91'
Pk in N side Trans. pole	E 101.72'

P.A. 345 OTTAWA COUNTY
PEER APPROVED B/22/94
Robert D. ...

C. Description of monument for corner and accessories established to perpetuate locating the position of the corner:

I-8 Cast Iron Monument	
O.C. Remon. Nail & Tag in E side 16" Sycamore	S30°W 40.81'
O.C. Remon. Nail & Tag in NE side 14" Wild Cherry	N65°W 66.32'
O.C. Remon. Nail & Tag in NW side PP	N30°W 60.59'
O.C. Remon. Nail & Tag in SE side 18" Sycamore	N40°E 55.02'
2' W of CL "x" 64th Avenue and Blair Street.	

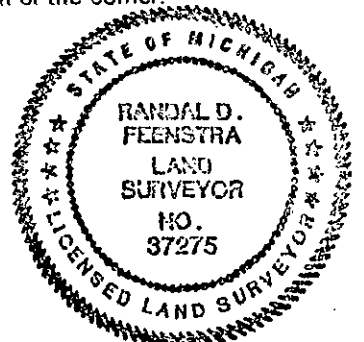

Signed by Randal D. Feenstra

Date May 4, 1994

Surveyor's Michigan License No. 37275