

SURVEY & REMONUMENTATION

APR 05 1996

**OTTAWA COUNTY REMONUMENTATION
LAND CORNER RECORDATION CERTIFICATE
Filing Requirement of Act 74, Mich. P.A. 1970**

For corners in **COMMISSION**

Ottawa (County)	Located In:	Corner Code #/
1. Public Land Survey	Blendon Twp. T <u>6N</u> R <u>14W</u>	J-7, N 1/4 cor. Sec. 23
2. Property Controlling in Section	S ___ T ___ R ___	
3. Miscellaneous Property in Sec.	S ___ T ___ R ___	

RECORDED

95 NOV 29 PM 1:38

Roger D. ...
REGISTER OF DEEDS
OTTAWA COUNTY, MI

Register of Deeds Stamp & File Number

4. Lot No. _____, Recorded Plat _____
5. Private Claims _____

I, Randal D. Feenstra, in a field survey on November 6, 1995, do hereby certify that under requirements of P.A. 74, Michigan P.A. of 1970, the corner points mentioned in lines 1 and 2 above were in conformance with regulations and rules therefore as required in the current manual of survey instructions of the United States Department of the Interior, Bureau of Land Management or by a decree of a Court of Law and/or that the corner points mentioned in lines 3, 4 and 5 above were in conformance with the rules of the Michigan Board of Land Surveyors or by a Decree of a Court of Law; established, re-established, monumented, re-monumented, recovered, found as expressed below:

A	B	C	D	E	F	G	H	I	J	K	L	M
2	6	5	4	3	2	1						
3												
4	7	8	9	10	11	12						
5												
6	18	17	16	15	14	13						
7												
8	19	20	21	22	23	24						
9												
10	30	29	28	27	26	25						
11												
12	31	32	33	34	35	36						
13												

NOTE: Not more than 4 corners, all in the same town and range, may be recorded on this certificate.

A. Description of original monument and accessories and/or subsequent restoration:

G.L.O. (1832) Calvin Britain 8" Maple S 15° 3 lks. 5" Beech N25°E 7 lks.	LIBER 1, PAGE 409 (1972) "T" Iron 20" Basswood ENE 66.18' P. Pole NE 59.25' 16" Basswood N 22.94' T. Pole SW 47.60' St. Sign N 13.92'	LIBER 4, PAGE 349 (1982) C.I.M. 12" Sassafras N 23.53' T. Pole SW 47.92' T. Pole NE 59.52' 16" Maple WSW 125.42'	LIBER 5, PAGE 281 (1987) C.I.M. 15" Sassafras N 23.56' T. Pole SW 47.95' P. Pole NE 59.54'
LIBER 6, Page 49 (1990) 4" x 4" Post SW 49.41' T. Pole SE 56.06' P. Pole NE 59.49'			

B. Description of corner evidence found and/or method applied in restoring or reestablishing corner:


Found: C.I.M. in box Accepted as a careful and faithful perpetuation of the position of the original corner.
Pk in E side 4" x 4" Post SW 49.20'
Pk in SW side T. Pole SE 55.90'

P.A. 345 OTTAWA COUNTY
PEER APPROVED 11/20/95
Randal D. Feenstra
YDY

C. Description of monument for corner and accessories established to perpetuate locating the position of the corner:

J-7	C.I.M. in Box		
	Ottawa County Remon. Nail & Tag in S.E. side P. pole	135°	55.86'
	Ottawa County Remon. Nail & Tag in SW side P. Pole	45°	58.44'
	Ottawa County Remoh. Nail & Tag in W end 12" CMP	310°	38.64'
	Ottawa County Remon. Nail & Tag in S end 12" CMP	250°	78.83'

3' E of centerline "X" 60th Ave. and Tyler St.

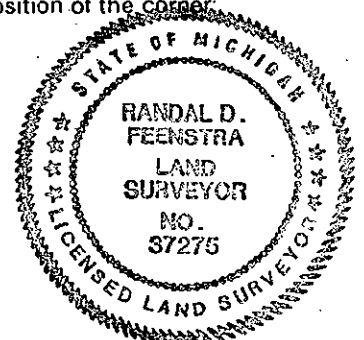

Signed by *Randal D. Feenstra* Date November 6, 1995
Surveyor's Michigan License No. 37275