

OCT 2 4 1994

## OTTAWA COUNTY REMONUMENTATION LAND CORNER RECORDATION CERTIFICATE Filing Requirement of Act 74, Mich. P.A. 1970

error of the contract of

RECORDED

94 OCT -7 PH 12: 33

For corners MONMISS!	ON
----------------------	----

Ottawa (County)		Located In:	Corner Code ##
1.	Public Land Survey	т <u>6N</u> R <u>14W</u> т R т В	K-3 NE COR Sec. 11, Blendon
2.	Property Controlling	T R S T R	
۷.	in Section	S T R	
3.	Miscellaneous Property in Sec.	S R S T R	10. 10. 10. 10.

\_ . Recorded Plat

Doly this Bellman REGISTER OF DEEDS OTTAWA COUNTY, MI

Register of Deeds Stamp & File Number

Randal D. Feenstra, in a field survey on May 26 do hereby certify that under requirements of P.A. 74, Michigan P.A. of 1970, the corner points mentioned in lines 1 and 2 above were in conformance with regulations and rules therefore as required in the current manual of survey instructions of the United States Department of the Interior, Bureau of Land Management or by a decree of a Court of Law and/or that the corner points mentioned in lines 3, 4 and 5 above were in conformance with the rules of the Michigan Board of Land Surveyors or by a Decree of a Court of Law; established, re-established, monumented, re-monumented, recovered, found as

NOTE: Not more than 4 corners, all in the same town and range, may be recorded on this certificate.

10 11 12 13

Description of original monument and accessories and/or subsequent restoration: L-2 Page 125 (1973)

.0 (1838) Pipe Beech S75°E 13.9

L-3 Page 122 (1976) Iron in Mon. Box

Sugar N57°W 9.9

IST

Lot No.

expressed below:

Private Claims

NW PP 78.06' Sq.Spike in N side 24" Maple E 44.60' ENE 24" Aspen 27.31' Sq.Spike in N side 26" Maple W-SW 103.19 NE 12" Oak 70.22' Pk in NE side of PP NW 78.62

nuel Marrs

-5 Page 122 (1984)

ΙM

PP NW 78.56 Poplar SE 54.97

5" E 43.72

31" Maple WSW 103.49

Description of corner evidence found and/or method applied in restoring or reestablishing corner:

C.I.M. in Monument Box - accepted as a careful and faithful perpetuation of the position of ound: ound Witnesses: the original corner.

Nail in SW side of 30" Poplar Nail in N side 38" Maple

S30°E 55.05′

S70°W 103.45′

Nail in S side 32" Maple

E 43.65'


P.A. 345 OTTAWA COU

PEER APPROVED

C. Description of monument for corner and accessories established to perpetuate locating the position of the corner:

K-3 Cast Iron Monument

80.34' O.C. Remon. Nail & tag in NE side PP N45°W 28.32 O.C. Remon. Nail & tag in N side 24" Twin Elm S70°W O.C. Remon. Nail & tag in N side 12" Pine O.C. Remon. Nail & tag in NW side 10" Elm S35°W 71.597 50.887 N35°E CE of 56th Avenue and  $\pm$  4' North of Taylor

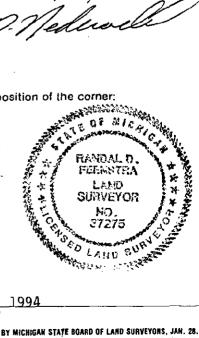

May 26, 1994

37275 Surveyor's Michigan License No. \_\_\_

Date