

SURVEY &  
REMONUMENTATION

OCT 24 1994

OTTAWA COUNTY REMONUMENTATION  
LAND CORNER RECORDATION CERTIFICATE  
Filing Requirement of Act 74, Mich. P.A. 1970

RECORDED

94 OCT -7 PH 12:33


For corners in **COMMISSION**

Ottawa	Located In:	Corner Code #
(County)		
1. Public Land Survey	T 6N R 14W	K-4E1/4 COR
	T _____ R _____	Sec. 11, Blendon
	T _____ R _____	
	T _____ R _____	
2. Property Controlling in Section	S _____ T _____ R _____	
	S _____ T _____ R _____	
3. Miscellaneous Property in Sec.	S _____ T _____ R _____	
	S _____ T _____ R _____	
4. Lot No. _____, Recorded Plat _____		
5. Private Claims _____		

*Poly... Addelman*  
REGISTER OF DEEDS  
OTTAWA COUNTY, MI

Register of Deeds Stamp & File Number

I, Randal D. Feenstra in a field survey on May 26, 19 94, do hereby certify that under requirements of P.A. 74, Michigan P.A. of 1970, the corner points mentioned in lines 1 and 2 above were in conformance with regulations and rules therefore as required in the current manual of survey instructions of the United States Department of the Interior, Bureau of Land Management or by a decree of a Court of Law and/or that the corner points mentioned in lines 3, 4 and 5 above were in conformance with the rules of the Michigan Board of Land Surveyors or by a Decree of a Court of Law; established, re-established, monumented, re-monumented, recovered, found as expressed below:

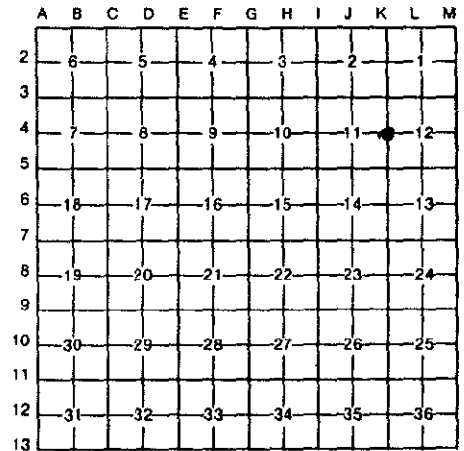

**NOTE: Not more than 4 corners, all in the same town and range, may be recorded on this certificate.**

A. Description of original monument and accessories and/or subsequent restoration:

GLO (1838) POST	L-1 Page 757 (1972)	L-4 Page 268 (1981)
6" Beech N87½°E 2.6	RR Spike	Cast Iron Monument
5" Beech N87°W 13.9	SW Cor Hse Fndn NE 98.46'	12" Walnut SW 52.92'
Samuel Marrs	NW Cor Hse Fndn SE 95.40'	NW Cor. Garage SE 78.75'
5 Page 337 (1988)	Spike in 24" Sycamore SW 41.30'	PP NW 68.50'
Mon.		14" Spruce NE 66.32'
Cor Garage Fndn. SE 78.91		
nl & tag in SE side 12" Walnut		
52.85'		

B. Description of corner evidence found and/or method applied in restoring or reestablishing corner:

Found CIM in Monument Box - accepted as a careful and faithful perpetuation of the position of the original corner.  
Found Witnesses;  
Pk nail SW side PP N45°W 68.65'  
Pk nail SW side PP N45°W 68.52'  
Nail & tag East side 14" Walnut S40°W 52.78'

P.A. 345 OTTAWA COUNTY  
PEER APPROVED 9/22/94  
*Randal D. Feenstra*

C. Description of monument for corner and accessories established to perpetuate locating the position of the corner:

K-4 Cast Iron Monument in Box		
O.C. Remon. Nail & tag W side 24" Pine	N45°E	65.91'
O.C. Remon. Nail & tag SW side PP	N45°W	68.49'
O.C. Remon. Nail & tag N side 12" Pine	S70°W	124.27'
O.C. Remon. Nail & tag E side PP	S30°W	95.61'
CL of Bauer 2' East of 56th Avenue		



Signed by Randal D. Feenstra Date May 26, 1994

Surveyor's Michigan License No. 37275