

**SURVEY &  
REMONUMENTATION**

APR 05 1996

**OTTAWA COUNTY REMONUMENTATION  
LAND CORNER RECORDATION CERTIFICATE  
Filing Requirement of Act 74, Mich. P.A. 1970**

**COMMISSION**

For corners in  
Ottawa

	Located in:	Corner Code #
(County)	Blendon Twp.	
1. Public Land Survey	T <u>6N</u> R <u>14W</u>	K-13, SE Cor.
	T _____ R _____	Sec. 35
	T _____ R _____	
	T _____ R _____	
2. Property Controlling in Section	S _____ T _____ R _____	
	S _____ T _____ R _____	
3. Miscellaneous Property in Sec.	S _____ T _____ R _____	
	S _____ T _____ R _____	

**RECORDED**

95 NOV 29 PM 1:38

*Ralph D. Hedwood*  
REGISTER OF DEEDS  
OTTAWA COUNTY, MI

**Register of Deeds Stamp & File Number**

4. Lot No. \_\_\_\_\_, Recorded Plat \_\_\_\_\_  
5. Private Claims \_\_\_\_\_

	A	B	C	D	E	F	G	H	I	J	K	L	M
2	6		5		4		3		2		1		
3													
4	7		8		9		10		11		12		
5													
6	18		17		16		15		14		13		
7													
8	19		20		21		22		23		24		
9													
10	30		29		28		27		26		25		
11													
12	31		32		33		34		35		36		
13													

I, Randal D. Feenstra, in a field survey on Nov. 6, 1995, do hereby certify that under requirements of P.A. 74, Michigan P.A. of 1970, the corner points mentioned in lines 1 and 2 above were in conformance with regulations and rules therefore as required in the current manual of survey instructions of the United States Department of the Interior, Bureau of Land Management or by a decree of a Court of Law and/or that the corner points mentioned in lines 3, 4 and 5 above were in conformance with the rules of the Michigan Board of Land Surveyors or by a Decree of a Court of Law, established, re-established, monumented, re-monumented, recovered, found as expressed below:

**NOTE: Not more than 4 corners, all in the same town and range, may be recorded on this certificate.**

- A. Description of original monument and accessories and/or subsequent restoration:  
 GLO (1831) LIBER 5, PAGE 75 (1983)  
 Calvin Britain C.I.M.  
 7" Beech N52°W 3 lks. P. Pole SSW 70.15'  
 6" Sugar N55.5°E 44 lks. F. Post SW 27.98'  
 F. Post NW 52.57'  
 Zeeland Cor. W 28.12'


- B. Description of corner evidence found and/or method applied in restoring or reestablishing corner:  
 Found: C.I.M. Accepted as a careful and faithful perpetuation of the position of the original corner.  
 Pk. in W. side P.Pole SW 72.99'  
 Zeeland Township corner (Mon) West 28.13'

PA. 315 OTTAWA COUNTY  
PEER APPROVED 11/20/95

*Randal D. Feenstra*  
*RD*

- C. Description of monument for corner and accessories established to perpetuate locating the position of the corner:  
 K-13 C.I.M. in gravel  
 Ottawa County Remon. Nail and Tag in E side P.Pole 200° 72.71'  
 Ottawa County Remon. Nail and Tag in N side F. Post 239° 59.73'  
 Ottawa County Remon. Nail and Tag in E end 12" CMP 11° 64.15'  
 Zeeland Township Cor (C.I.M.) 270° 8.13'

on centerline New Holland and 5' E of centerline 56th

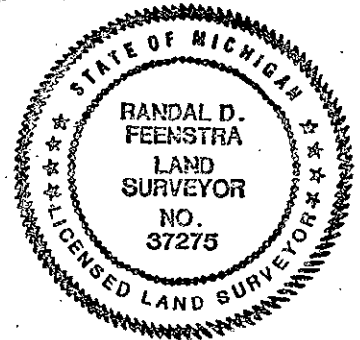

Signed by Randal D. Feenstra Date Nov. 6, 1995  
37275

Surveyor's Michigan License No. \_\_\_\_\_