

SURVEY & REMONUMENTATION

FEB 27 1998

OTTAWA COUNTY REMONUMENTATION

SECTION

LAND CORNER RECORDATION CERTIFICATE Filing Requirement of Act 74, Mich. P.A. 1970

For corners in

Ottawa

(County)

Located In:

Corner Code #

Blendon Twp.

1. Public Land Survey

T 6N R 14W

M-2, E 1/4 corner

T R

Sec. 1

T R

T R

2. Property Controlling
in Section

S T R

S T R

3. Miscellaneous
Property In Sec.

S T R

S T R

4. Lot No. , Recorded Plat

5. Private Claims

RECORDED

97 DEC -8 AM 11:27

Dany [Signature]
REGISTER OF DEEDS
OTTAWA COUNTY, MI

Register of Deeds Stamp & File Number

I, Randal D. Feenstra, in a field survey on Feb. 17, 1997 do hereby state that under requirements of P.A. 74, Michigan P.A. of 1970, the corner points mentioned in lines 1 and 2 above were in conformance with regulations and rules therefore as required in the current manual of survey instructions of the United States Department of the Interior, Bureau of Land Management or by a decree of a Court of Law and/or that the corner points mentioned in lines 3, 4 and 5 above were in conformance with the rules of the Michigan Board of Land Surveyors or by a Decree of a Court of Law; established, re-established, monumented, recovered, found as expressed below.

NOTE: Not more than 2 corners, all in the same town and range, may be recorded on this certificate.

A	B	C	D	E	F	G	H	I	J	K	L	M
1												
2	6	5	4	3	2	1						
3												
4	7	8	9	10	11	12						
5												
6	18	17	16	15	14	13						
7												
8	19	20	21	22	23	24						
9												
10	30	29	28	27	26	25						
11												
12	31	32	33	34	35	36						
13												

A. Description of original monument and accessories and/or subsequent restoration:

G.L.O. (1831)	LCRC, L-5, P-74
Lucius Lyon DS	M-2 Found Iron Bar
Set N.W. Post	No Ties
9" Black Ash S. 22°W 17lks	Set Cast Iron Monument
10" Black Ash N. 18°W 20lks	PP NE 93.91
	18" Maple NW 40.75
	16" Hickory WNW 96.50
	13" Hickory WSW 89.65

B. Description of corner evidence found and/or method applied in restoring or reestablishing corner:

M-2 Found: Cast Iron Monument in Mon. Box

P.K. E Side	P. Pole	NE	93.96'
Nail NE Side	22" Maple	N44°W	40.91
Nail S Side	16" Hickory	WSW	89.66
Nail S Side	18" Hickory	WNW	96.34

P.A. 345 OTTAWA COUNTY
PEER APPROVED 8-18-97


[Signature]

Accepted as a careful and faithful perpetuation of the position of the original corner

C. Description of monument for corner and accessories established to perpetuate locating the position of the corner:

M-2 Found: Cast Iron Monument in Monument Box

Ottawa County Remon Nail and Tag in E side P. Pole	N 28°E 93.96'
Ottawa County Remon Nail and Tag in NE side 22" Maple	N 44°W 40.91'
Ottawa County Remon Nail and Tag in S side 16" Hickory	S 73°W 89.66'
Ottawa County Remon Nail and Tag in S side 18" Hickory	N 77°W 96.34'
Centerline Gravel Rd. to W (Stanton St.)	N 2' ±
On centerline N-S bit. rd. (48th Ave.)	
Tree and brush row to E S	3' ±

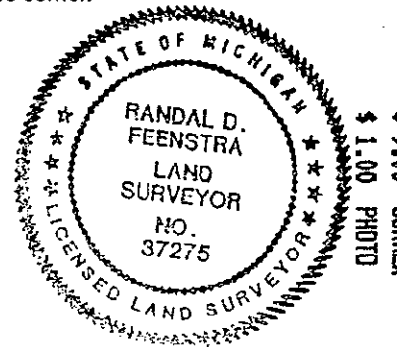

Signed by Randal D. Feenstra
Surveyor's Michigan License No. 37275

Date Feb. 17, 1997