

SURVEY & REMONUMENTATION

NOV 16 1993

COMMISSION

LAND CORNER RECORDATION CERTIFICATE

Filing Requirement of Act 74, Mich. P.A. 1970
OTTAWA COUNTY REMONUMENTATION

For corners in
OTTAWA
(County)

Located In: BLENDON TWP. Corner Code #

1. Public Land Survey	T <u>6N</u> R <u>14W</u>	<u>M-8</u> , E $\frac{1}{4}$ Cor-24
	T <u>6N</u> R <u>14W</u>	K-9, SW Cor-24
	T _____ R _____	_____
	T _____ R _____	_____
2. Property Controlling in Section	S _____ T _____ R _____	_____
	S _____ T _____ R _____	_____
3. Miscellaneous Property in Sec.	S _____ T _____ R _____	_____
	S _____ T _____ R _____	_____

RECORDED

1993 SEP 29 PM 3:13

Phyllis Williams
REGISTER OF DEEDS
OTTAWA COUNTY, MI

Register of Deeds Stamp & File Number

4. Lot No. _____, Recorded Plat _____
5. Private Claims _____

	A	B	C	D	E	F	G	H	I	J	K	L	M
2	6	5	4	3	2	1							
3													
4	7	8	9	10	11	12							
5													
6	18	17	16	15	14	13							
7													
8	19	20	21	22	23	24							
9													
10	30	29	28	27	26	25							
11													
12	31	32	33	34	35	36							
13													

I, Randal D. Feenstra in a field survey on July 13, 1993, do hereby certify that under requirements of P.A. 74, Michigan P.A. of 1970, the corner points mentioned in lines 1 and 2 above were in conformance with regulations and rules therefore as required in the current manual of survey instructions of the United States Department of the Interior, Bureau of Land Management or by a decree of a Court of Law and/or that the corner points mentioned in lines 3, 4 and 5 above were in conformance with the rules of the Michigan Board of Land Surveyors or by a Decree of a Court of Law; established, re-established, monumented, re-monumented, recovered, found as expressed below:

NOTE: Not more than 4 corners, all in the same town and range, may be recorded on this certificate.

A. Description of original monument and accessories and/or subsequent restoration:


M-8 = LCRC#'s L-1, P-329; L-3, P-79; L-5, P-273

K-9 = LCRC#'s L-1, P-329; L-1, P-759; L-5, P-121

B. Description of corner evidence found and/or method applied in restoring or reestablishing corner:

M-8
Found Cast Iron Monument-0.5' below road grade-And Witnesses Per LCRC # L-5, P-273

K-9
Found Cast Iron Monument in box And Witnesses Per LCRC # L-5, P-121

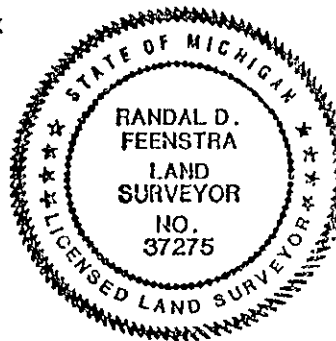

C. Description of monument for corner and accessories established to perpetuate locating the position of the corner:

M-8-Cast Iron Monument per L-5, P-273, Ottawa County, MI, and is accepted as a careful and faithful perpetuation of the position of the original corner	O.C. Remon. Nail & Tag in Power Pole	S72°E	60.92
	O.C. Remon. Nail & Tag in Telephone P.	N82°W	32.11
	SW cor. of bottom step to porch-Hse#6790	S50°E	132.24
	Georgetown Twp. cor. (Cast Iron Monument)	S0°E	14.66
	CL 48th 1'W	CL Tree line to East	
K-9-Cast Iron Monument per L-5, P-121, Ottawa County, MI, and is accepted as a careful and faithful perpetuation of the position of the original corner	O.C. Remon. Nail & Tag in Power Pole	N20°W	54.19
	O.C. Remon. Nail & Tag in Power Pole	S34°E	47.58
	O.C. Remon. Nail & Tag in 19" Maple	S40°W	59.42
	NE Cor bottom porch step on NE cor. Hse#	S51°E	106.20
	CL Port Sheldon & 56th	(5584)	

Signed by Randal D. Feenstra Date July 13, 1993

Surveyor's Michigan License No. 37275