

FEB 24 2000

RECORDED

99 DEC -2 PM 1:13

OTTAWA COUNTY REMONUMENTATION

SECTION

LAND CORNER RECORDATION CERTIFICATE
Filing Requirement of Act 74, Mich. P.A. 1970

Larry Sublette
REGISTER OF DEEDS
OTTAWA COUNTY, MI

For corners in

OTTAWA

Located In:

Corner Code #

(County)

1. Public Land Survey

T 6N R 15W A-12 W 1/4 Corner
T R Section 31, Olive
T R Twp

2. Property Controlling in Section

S T R
S T R

3. Miscellaneous Property in Sec.

S T R
S T R

4. Lot No. _____, Recorded Plat _____

5. Private Claims _____

Register of Deeds Stamp & File Number

I, Randal J. Vugteveen, in a field survey on October 26, 1999 do hereby state that under requirements of P.A. 74, Michigan P.A. of 1970, the corner points mentioned in lines 1 and 2 above were in conformance with regulations and rules therefore as required in the current manual of survey instructions of the United States Department of the Interior, Bureau of Land Management or by a decree of a Court of Law and /or that the corner points mentioned in lines 3, 4 and 5 above were in conformance with the rules of the Michigan Board of Land Surveyors or by a Decree of a Court of Law; established, re-established, monumented, recovered, found as expressed below:

A	B	C	D	E	F	G	H	I	J	K	L	M
1												
2	6		5		4		3		2		1	
3												
4	7		8		9		10		11		12	
5												
6	18		17		16		15		14		13	
7												
8	19		20		21		22		23		24	
9												
10	30		29		28		27		26		25	
11												
12	31		32		33		34		35		36	
13												

NOTE: Not more than 2 corners, all in the same town and range, may be recorded on this certificate.

A. Description of original monument and accessories and/or subsequent restoration:

A-12 (This corner was not set by GLO)

A-12 Liber 4, Page 320

June 1982 Greer

1" Iron Pipe

Power Pole SW 69.14'

12" White Pine S60°W 71.20'

Centerline Pipeline marker N20°W 46.90'

Centerline street sign N70°E 74.51'

A-12 Liber 4, Page 338

September 1982, Joiner

Set Cast Iron Monument

Telephone Ped SSW 18.28'

Pipeline marker SW 27.32'

Pipe in N Hdwl NE 16.15'

Port Sheldon Corner N 17.87'

M-12 Peer Approved November 21, 1994

Liber 1, Page 432 (Clapp)

Found Ottawa County Cast Iron Monument

Nail & Remon Tag in NW face 9" Pine Az 236°

85.83'

Nail & Remon Tag in WNW face Power Pole Az

198° 86.39'

Nail & Remon Tag in N face 6" Pine Az 111°

143.33'

Olive Township Corner Az 180° 18.13'

B. Description of corner evidence found and/or method applied in restoring or reestablishing corner:

A-12 Corner was removed by Ottawa County Road Commission September 1999

Found Nail in E side Power Pole S20°W 69.41'

Face 18" White Pine S60°W 70.7'

Centerline Pipeline marker N20°W 47.15'

Centerline Street Sign N70°E 74.04'

A-11, T6N, R15W N 2650.00'

A-13, T6N, R15W South 2651.33'

This position not established by original government surveyors. Accepted distance of 18.13' South of Port Sheldon corner on Peer Approved LCRC Liber 1, Page 432 (Clapp 1994)

Set 3/4" X 36" Long Solid Iron Bar 18.13' South of M-12 corner Port Sheldon Township on Township Line

11/15/99
[Signature]

C. Description of monument for corner and accessories established to perpetuate locating the position of the corner:

A-12 3/4" X 36" Solid Iron Bar with Remon Cap

Found Nail & Remon Tag in N side 8" Pine S75°E 137.12'

Found Nail & Remon Tag in W side Power Pole S20°E 69.53'


Set Nail & Remon Tag in S side 20" Pine S60°W 71.56'

Center Street Sign N70°E 74.04'

Remon Bar and Cap (M-12 Port Sheldon Twp) North 18.13'

Centerline North and South Road East 43'

Centerline East and West Road South 3'

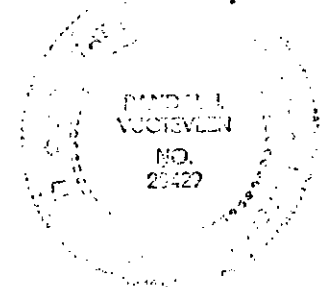

\$11.00 CORNER
Receipt #64945

Signed by *[Signature]*

Date October 27, 1999

Surveyor's Michigan License No. 28429

FEB 24 2000

SECTION

