

SURVEY & REMONUMENTATION

JUN 28 1999

RECORDED

SECTION

OTTAWA COUNTY REMONUMENTATION 98 NOV -4 PM 2: 30

LAND CORNER RECORDATION CERTIFICATE
Filing Requirement of Act 74, Mich. P.A. 1970

For corners in
OTTAWA
(County)

Located In: Corner Code #

- 1. Public Land Survey T 6N R 15W B-13 S 1/4 Cor. Sec
T R 31 Olive Twp.
- 2. Property Controlling in Section S T R
- 3. Miscellaneous Property in Sec. S T R

Randy Vugteveen
REGISTER OF DEEDS
OTTAWA COUNTY, MI

Register of Deeds Stamp & File Number

- 4. Lot No. _____, Recorded Plat _____
- 5. Private Claims _____

I, Randal J. Vugteveen, in a field survey on September 30, 1998 do hereby state that under requirements of P.A. 74, Michigan P.A. of 1970, the corner points mentioned in lines 1 and 2 above were in conformance with regulations and rules therefore as required in the current manual of survey instructions of the United States Department of the Interior, Bureau of Land Management or by a decree of a Court of Law and /or that the corner points mentioned in lines 3, 4 and 5 above were in conformance with the rules of the Michigan Board of Land Surveyors or by a Decree of a Court of Law, established, re-established, monumented, recovered, found as expressed below:

NOTE: Not more than 2 corners, all in the same town and range, may be recorded on this certificate.

A	B	C	D	E	F	G	H	I	J	K	L	M
1												
2	6	5	4	3	2	1						
3												
4	7	8	9	10	11	12						
5												
6	18	17	16	15	14	13						
7												
8	19	20	21	22	23	24						
9												
10	30	29	28	27	26	25						
11												
12	31	32	33	34	35	36						
13												

A. Description of original monument and accessories and/or subsequent restoration:

Description of original monument and accessories and / of subsequent restoration:

- Remon Liber 3, Page 165
- B-13 Cast Iron Mon (on Centerline E & W 6' E of Centerline N)
- Remon Tag and Nail NE side Power Pole S50°E 79.32'
- Remon Tag and Nail S side 10" Pine N80°E 182.03'
- Remon Tag and Nail N end Cmp N40°E 32.51'
- Remon Tag and Nail 12"Tree S20°E 161.04'

B. Description of corner evidence found and/or method applied in restoring or reestablishing corner:

B-13 Found busted Harrison Cast Iron Monument

- Found Remon Tag and Nail (T & N) NE side P Pole S50°E 79.30'
- Found Remon T & N W side 12" Elm S20°E 161.04'
- Found Remon T & N S side 12" Pine N80°E 182.05'
- PK T & N in top of North end Cmp Pipe N40°E 32.49'
- Found Cast Iron Monument N90°E 68.49' (Holland Twp Cor)


Accepted Cast Iron Monument as a careful and faithful perpetuation of the position of the original corner.

Removed Top extension to Cast Iron Monument set 3/4" X 24" Steel Bar with Remon Cap

C. Description of monument for corner and accessories established to perpetuate locating the position of the corner:

B-13 Cast Iron Monument set 3/4" X 24" Steel Bar with Remon Cap

- Found Remon Tag and Nail NE side P Pole S50°E 79.30'
- Found Remon Tag and Nail S side 12" Elm S20°E 161.04'
- Found Remon Tag and Nail S side 12" Pine N80°E 182.05'
- PK Tag and Nail in top of North end Cmp N40°E 32.49'
- Found Cast Iron Monument N90°E 68.49' (Holland Twp Cor)
- On E & W Gravel Road, 8' East of Two-Track to North

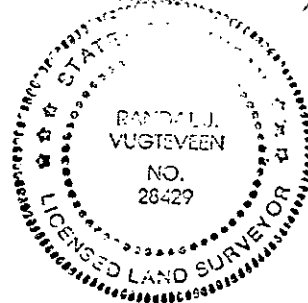

\$9.00 CORNER
Receipt #18213
\$1.00 PHOTO
Receipt #18213

Signed by *Randal J. Vugteveen*
Surveyor's Michigan License No. 28429

Date OCTOBER 19, 1998