

**SURVEY &
REMONUMENTATION**

APR 05 1996

COMMISSION

OTTAWA COUNTY REMONUMENTATION

LAND CORNER RECORDATION CERTIFICATE

Filing Requirement of Act 74, Mich. P.A. 1970

RECORDED

95 DEC 12 PM 4: 51

Richard Robinson
REGISTER OF DEEDS
OTTAWA COUNTY, MI

For corners in

Ottawa (County)	Located in:	Corner Code #
1. Public Land Survey	T 6N R15W T _____ R _____ T _____ R _____ T _____ R _____	B-13 (S 1/4 cor., Sec. 31 Olive Twp.)
2. Property Controlling in Section	S _____ T _____ R _____ S _____ T _____ R _____	_____
3. Miscellaneous Property in Sec.	S _____ T _____ R _____ S _____ T _____ R _____	_____
4. Lot No. _____, Recorded Plat _____		
5. Private Claims _____		

Register of Deeds Stamp & File Number

	A	B	C	D	E	F	G	H	I	J	K	L	M
2	6	5	4	3	2	1							
3													
4	7	8	9	10	11	12							
5													
6	18	17	16	15	14	13							
7													
8	19	20	21	22	23	24							
9													
10	30	29	28	27	26	25							
11													
12	31	32	33	34	35	36							
13													

I, Douglas J. Koning, in a field survey on November 22, 1995, do hereby certify that under requirements of P.A. 74, Michigan P.A. of 1970, the corner points mentioned in lines 1 and 2 above were in conformance with regulations and rules therefore as required in the current manual of survey instructions of the United States Department of the Interior, Bureau of Land Management or by a decree of a Court of Law and/or that the corner points mentioned in lines 3, 4 and 5 above were in conformance with the rules of the Michigan Board of Land Surveyors or by a Decree of a Court of Law; established, re-established, monumented, re-monumented, recovered, found as expressed below:

NOTE: Not more than 4 corners, all in the same town and range, may be recorded on this certificate.

A. Description of original monument and accessories and/of subsequent restoration:

B-13 Government Notes Set Post April 1832 Hemlock 12" N43°E 17 Links Pepperage 10" N57°W 17 Links Calvin Britain D.S.	L.C.R.C. Liber 4, Page 310 April 1982 B-13 Set Cast Iron Monument Street Sign NW 42.45' Power Pole SW 78.88' Centerline Telephone Pole SW 45.70' Holland Corner E 68.53'	L.C.R.C. Liber 1, Page 515 July 1972 B-13 Iron Pipe Street Sign SSW 22.95' Nail in face of Power pole SE 78.75' Nail in face of 36" Ash SE 74.46'
---	---	---

P.A. 345 OTTAWA COUNTY
PEER APPROVED 12/11/95

Maday D. Hedewell
SDP


B. Description of corner evidence found and/or method applied in restoring or reestablishing corner.

B-13 Found Cast Iron Monument
Found Cast Iron Monument E 68.52'
Found Nail & Tag W side Power Pole SE 78.85'

This marker is accepted as a careful and faithful perpetuation of the original corner.

C. Description of monument for corner and accessories established to perpetuate locating the position of the corner.

B-13 Cast Iron Monument (on Centerline E-W, 6' E of Centerline N)
Set Remon Tag & Nail in NE side Power Pole S50°E 79.32'
Set Remon Tag & Nail in S side 10" Pine N80°E 182.03'
Set Remon Tag & Nail in N end CMP N40°E 32.51'
Set Remon Tag & Nail in 12" Tree S20°E 161.04'

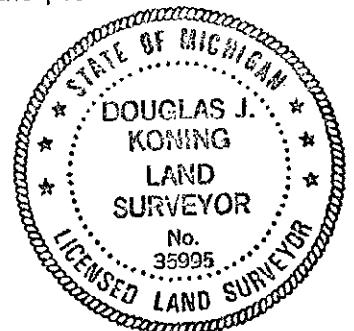

Signed by Douglas J. Koning
Surveyor's Michigan License No. 35995

Date 12-11-95