

SURVEY & REMONUMENTATION

OCT 07 1996

COMMISSION

**OTTAWA COUNTY REMONUMENTATION
LAND CORNER RECORDATION CERTIFICATE**

RECORDED

For corners in

Filing Requirement of Act 74, Mich. P.A. 1970

96 AUG 25 PM 2: 01

<u>Ottawa</u> (County)	Located in:	Corner Code #
1. Public Land Survey	T 6N R 15W	C-2
	T _____ R _____	(E 1/4 cor., Sec. 6
	T _____ R _____	Olive Twp.)
	T _____ R _____	
2. Property Controlling in Section	S _____ T _____ R _____	
	S _____ T _____ R _____	
3. Miscellaneous Property in Sec.	S _____ T _____ R _____	
	S _____ T _____ R _____	
4. Lot No. _____, Recorded Plat _____		
5. Private Claims _____		

Phyllis Chittman
REGISTER OF DEEDS
OTTAWA COUNTY, MI

Register of Deeds Stamp & File Number

A	B	C	D	E	F	G	H	I	J	K	L	M
2	6	▲	5	4	3	2	1					
3												
4	7	8	9	10	11	12						
5												
6	18	17	16	15	14	13						
7												
8	19	20	21	22	23	24						
9												
10	30	29	28	27	26	25						
11												
12	31	32	33	34	35	36						
13												

Douglas J. Koning, In a field survey on February 20, 1996, do hereby certify that under requirements of P.A. 74, Michigan P.A. of 1970, the corner points mentioned in lines 1 and 2 above were in conformance with regulations and rules therefore as required in the current manual of survey instructions of the United States Department of the Interior, Bureau of Land Management or by a decree of a Court of Law and/or that the corner points mentioned in lines 3,4 and 5 above were in conformance with the rules of the Michigan Board of Land Surveyors or by a Decree of a Court of Law; established, re-established, monumented, re-monumented, recovered, found as expressed below:

NOTE: Not more than 4 corners, all in the same town and range, may be recorded on this certificate.

A. Description of original monument and accessories and/or subsequent restoration:

C-2 Government Notes	L.C.R.C. Liber 2, Page 571 September 1974
Set Post May 1832	C-2 Found "T" Iron & Stone
By Calvin Britain D.S.	Set Cast Iron Monument
Pine 18" S60°W 8 Links	30" Maple NW 46.28'
Leo 15" N55°E 15 Links	Centerline Street Sign NW 38.80'
	12" Maple ENE 59.29'
	30" Oak SE 49.50'
	Twin 6" Pepperidge SW 74.00'

P.A. 345 OTTAWA COUNTY
PEER APPROVED 8-20-96

Richard P. McDowell

B. Description of corner evidence found and/or method applied in restoring or reestablishing corner.


C-2 Found Cast Iron Monument 1'± Deep	
Found Nail in face 18" Maple	ENE 59.94'
Found Nail & Tag in face 36" Oak	SE 49.41'
Found Nail & Tag in face 32" Maple	NW 46.29'
Found Nail Sly side 32" Maple	NW 46.94'

This marker is accepted as a careful and faithful perpetuation of the original corner.

C. Description of monument for corner and accessories established to perpetuate locating the position of the corner.

C-2 Cast Iron Monument	
Set Remon Tag & Nail NEly side 32" Maple	N55°W 47.62'
Set Remon Tag & Nail Wly side 12" Twin Oak	S20°W 74.40'
Set Remon Tag & Nail SWly side 36" Oak	S40°E 50.74'
Set Remon Tag & Nail Sly side 15" Triple Maple	N77°E 86.17'
in Centerline "X" of Roads	

Signed by Douglas J. Koning
Surveyor's Michigan License No. 35995

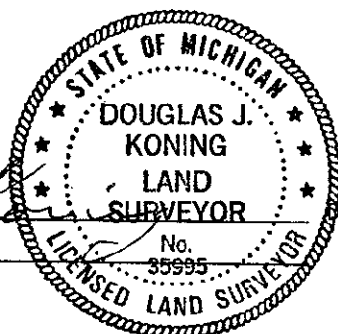

Date 8-20-96