

**SURVEY &
REMONUMENTATION**

OCT 07 1996

COMMISSION

**OTTAWA COUNTY REMONUMENTATION
LAND CORNER RECORDATION CERTIFICATE**

For corners in

Filing Requirement of Act 74, Mich. P.A. 1970

RECORDED

96 AUG 26 PM 2:01

Elycia Whitman
REGISTER OF DEEDS
OTTAWA COUNTY, MI

<u>Ottawa</u> (County)	Located in:	Corner Code #
1. Public Land Survey	T <u>6N</u> R <u>15W</u>	C-3
	T _____ R _____	(SE cor., Sec. 6
	T _____ R _____	Olive Twp.)
	T _____ R _____	
2. Property Controlling in Section	S _____ T _____ R _____	
	S _____ T _____ R _____	
3. Miscellaneous Property in Sec.	S _____ T _____ R _____	
	S _____ T _____ R _____	
4. Lot No. _____, Recorded Plat _____		
5. Private Claims _____		

Register of Deeds Stamp & File Number

A	B	C	D	E	F	G	H	I	J	K	L	M
2	6	5	4	3	2	1						
3		▲										
4	7	8	9	10	11	12						
5												
6	18	17	16	15	14	13						
7												
8	19	20	21	22	23	24						
9												
10	30	29	28	27	26	25						
11												
12	31	32	33	34	35	36						
13												

Douglas J. Koning, in a field survey on February 20, 1996, do hereby certify that under requirements of P.A. 74, Michigan P.A. of 1970, the corner points mentioned in lines 1 and 2 above were in conformance with regulations and rules therefore as required in the current manual of survey instructions of the United States Department of the Interior, Bureau of Land Management or by a decree of a Court of Law and/or that the corner points mentioned in lines 3, 4 and 5 above were in conformance with the rules of the Michigan Board of Land Surveyors or by a Decree of a Court of Law; established, re-established, monumented, re-monumented, recovered, found as expressed below:

NOTE: Not more than 4 corners, all in the same town and range, may be recorded on this certificate.

A. Description of original monument and accessories and/of subsequent restoration:

C-3 Government Notes	L.C.R.C. Liber 2, Page 571	September 1974
Set Post May 1832	C-3 Found Iron Bar & Stone	
By Calvin Britain D.S.	Set Cast Iron Monument	
Hemlock 15" N69°E 10 Links	20" Maple	NW 42.06'
Leo 8" S23°W 6 Links	20" Maple	WNW 52.78'
	Twin 8" Maple	SE 57.41'
	Power Pole	SSE 123.92'

P.A. 345 OTTAWA COUNTY
PEER APPROVED 8-20-96

Edward Nederwelt

B. Description of corner evidence found and/or method applied in restoring or reestablishing corner.


C-3 Found Cast Iron Monument 1' Deep
Found Nail Wly side 30" Maple NW 43.27'
Found Nail & Tag in face of Power Pole SSE 123.87'

This marker is accepted as a careful and faithful perpetuation of the original corner.

C. Description of monument for corner and accessories established to perpetuate locating the position of the corner.

C-3 Cast Iron Monument 1' Deep
Set Remon Tag & Nail in Wly side 30" Maple N40°W 43.21'
Set Remon Tag & Nail in Nly side 10" Twin Maple N70°E 59.69'
Set Remon Tag & Nail in Sly side 14" Twin Maple S78°E 57.69'
Set Remon Tag & Nail in Ely side Power Pole S71°E 124.21'
In Centerline ± N-S Road

Signed by Douglas J. Koning
Surveyor's Michigan License No. 35995

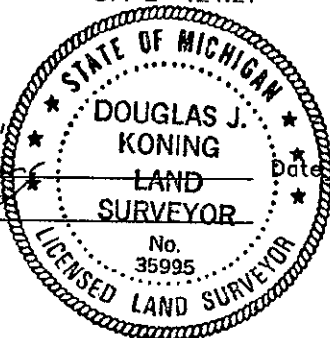

Date 8-20-96