

1993

RECORDED

OTTAWA COUNTY REMONUMENTATION
LAND CORNER RECORDATION CERTIFICATE
Filing Requirement of Act 74, Mich. P.A. 1970

93 DEC 15 AM 9:26

COMMISSION

Douglas J. Koning
REGISTER OF DEEDS
OTTAWA COUNTY, MI


For corners in

Ottawa (County)	Located in:	Corner Code #
1. Public Land Survey	T <u>6N</u> R <u>15W</u>	<u>C-5</u>
	T _____ R _____	<u>(NW cor. Sec.17</u>
	T _____ R _____	<u>Olive Twp.)</u>
	T _____ R _____	_____
2. Property Controlling in Section	S _____ T _____ R _____	_____
	S _____ T _____ R _____	_____
3. Miscellaneous Property in Sec.	S _____ T _____ R _____	_____
	S _____ T _____ R _____	_____

Register of Deeds Stamp & File Number

4. Lot No. _____, Recorded Plat _____
5. Private Claims _____

I, Douglas J. Koning, in a field survey on November 30, 1993, do hereby certify that under requirements of P.A. 74, Michigan P.A. of 1970, the corner points mentioned in lines 1 and 2 above were in conformance with regulations and rules therefore as required in the current manual of survey instructions of the United States Department of the Interior, Bureau of Land Management or by a decree of a Court of Law and/or that the corner points mentioned in lines 3, 4 and 5 above were in conformance with the rules of the Michigan Board of Land Surveyors or by a Decree of a Court of Law; established, re-established, monumented, re-monumented, recovered, found as expressed below:

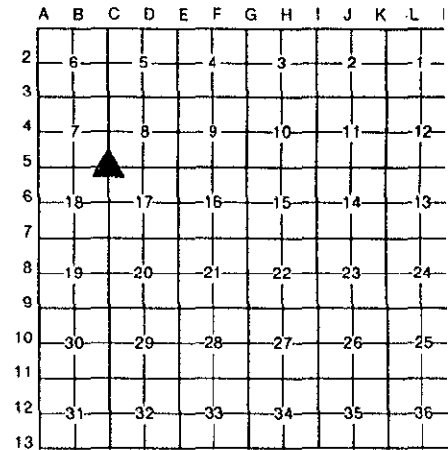

NOTE: Not more than 4 corners, all in the same town and range, may be recorded on this certificate.

A. Description of original monument and accessories and/or subsequent restoration:

L.C.R.C. L. 2 P. 573	1974	L.C.R.C. L. 6 P. 125	1991
C-5 Found T Iron in Old Iron Pipe		C-5 Reset CIM	
Set Cast Iron Mon.		8" Pine	SW 49.01'
PP	SW 58.04'	Cor. Fence Post	SE 47.66'
10" Maple	NW 61.36'	Cor. Fence Post	NE 46.04'
6" Pine	SW 54.50'	Clump Maples	NW 60.80'
Fence Post	NE 39.53'		


B. Description of corner evidence found and/or method applied in restoring or reestablishing corner:

C-5 Found Cast Iron Mon	
Nail in W side 8" Pine	SW 48.96'
Nail in SW side cor. Fence Post	SE 47.68'
Nail in SE side cor. Fence Post	NE 46.07'
Nail & Tag E face PP	SW 57.94'
Nail & Tag NE face 8" Pine	SW 54.42'

This marker is accepted as a careful and faithful perpetuation of the original corner.

C. Description of monument for corner and accessories established to perpetuate locating the position of the corner:

C-5 Cast Iron Mon (1.5' Deep)	
Nail and O.C. Remon Tag NW side 8" Pine	S35°W 54.71'
Nail and O.C. Remon Tag W side 18" Tw Oak	S25°E 114.56'
Nail and O.C. Remon Tag N side PP	S70°W 58.21'
Nail and O.C. Remon Tag NE Root Maple Clump	N15°W 59.63'
Centerline Dirt Raod (136TH AVE)	E 5.00'
On Centerline to East	

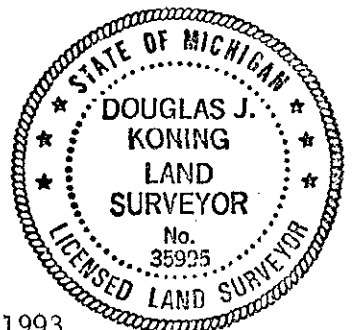

Signed by Douglas J. Koning
Surveyor's Michigan License No. 35995

Date December 6, 1993