

1893  
COMMISSION

OTTAWA COUNTY REMONUMENTATION  
LAND CORNER RECORDATION CERTIFICATE 93 DEC 15 AM 9:26  
Filing Requirement of Act 74, Mich. P.A. 1970

RECORDED

*Douglas J. Koning*  
REGISTER OF DEEDS  
OTTAWA COUNTY, MI

For corners in  
Ottawa

(County)	Located In:	Corner Code #
1. Public Land Survey	T 6N R 15W	C-6
	T _____ R _____	(W 1/4 cor. Sec.
	T _____ R _____	17, Olive Twp.)
	T _____ R _____	
2. Property Controlling in Section	S _____ T _____ R _____	
	S _____ T _____ R _____	
3. Miscellaneous Property in Sec.	S _____ T _____ R _____	
	S _____ T _____ R _____	

Register of Deeds Stamp & File Number

4. Lot No. \_\_\_\_\_, Recorded Plat \_\_\_\_\_  
5. Private Claims \_\_\_\_\_

I, Douglas J. Koning, in a field survey on November 30, 19 93, do hereby certify that under requirements of P.A. 74, Michigan P.A. of 1970, the corner points mentioned in lines 1 and 2 above were in conformance with regulations and rules therefore as required in the current manual of survey instructions of the United States Department of the Interior, Bureau of Land Management or by a decree of a Court of Law and/or that the corner points mentioned in lines 3, 4 and 5 above were in conformance with the rules of the Michigan Board of Land Surveyors or by a Decree of a Court of Law; established, re-established, monumented, re-monumented, recovered, found as expressed below:

**NOTE: Not more than 4 corners, all in the same town and range, may be recorded on this certificate.**

	A	B	C	D	E	F	G	H	I	J	K	L	M
2	6		5		4		3		2		1		
3													
4	7		8		9		10		11		12		
5													
6	16		17		16		15		14		13		
7													
8	19		20		21		22		23		24		
9													
10	30		29		28		27		26		25		
11													
12	31		32		33		34		35		36		
13													

A. Description of original monument and accessories and/or subsequent restoration:

L.C.R.C. L. 4 P. 204 1981  
C-6 Set Cast Iron Monument  
10" Oak ENE 56.40'  
10" Oak NW 84.06'  
5" Pine SW 44.70'  
Power Pole W 56.59'


B. Description of corner evidence found and/or method applied in restoring or reestablishing corner:

C-6 Found cast Iron Monument  
Centerline 14" Oak ENE 56.40'  
Nail and Tag N Side P Pole W 56.62'

This marker is accepted as a careful and faithful perpetuation of the original corner.

C. Description of monument for corner and accessories established to perpetuate locating the position of the corner:

C-6 Cast Iron Monument (Centerline N-S road)  
Nail and O.C. Remon Tag SW side 22" Oak N20°W 84.13'  
Nail and O.C. Remon Tag S side P Pole W 56.66'  
Nail and O.C. Remon Tag NE side 14" Sassafras S60°E 68.59'  
Nail and O.C. Remon Tag N side 12" Pine N65°E 99.34'  
Nail and O.C. Remon Tag W side 8" Db1 Oak N20°E 125.21'

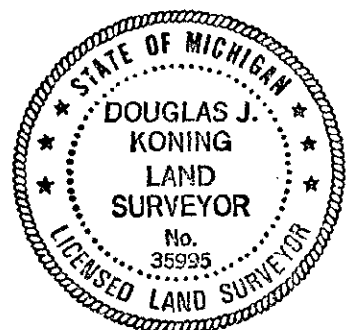

Signed by Douglas J. Koning Date December 6, 1993  
Surveyor's Michigan License No. 35995