

RECORDED

93 DEC 15 AM 9:26

OTTAWA COUNTY REMONUMENTATION
LAND CORNER RECORDATION CERTIFICATE
Filing Requirement of Act 74, Mich. P.A. 1970

D. J. Koning
REGISTER OF DEEDS
OTTAWA COUNTY, MI

For corners in

<u>Ottawa</u> (County)	Located In:	Corner Code #
1. Public Land Survey	T <u>6N</u> R <u>15W</u>	<u>C-7</u>
	T _____ R _____	(SW cor. Sec.
	T _____ R _____	<u>17, Olive Twp.</u>)
	T _____ R _____	_____
2. Property Controlling in Section	S _____ T _____ R _____	_____
	S _____ T _____ R _____	_____
3. Miscellaneous Property in Sec.	S _____ T _____ R _____	_____
	S _____ T _____ R _____	_____

Register of Deeds Stamp & File Number

4. Lot No. _____, Recorded Plat _____
5. Private Claims _____

I, Douglas J. Koning, in a field survey on November 30, 19 93, do hereby certify that under requirements of P.A. 74, Michigan P.A. of 1970, the corner points mentioned in lines 1 and 2 above were in conformance with regulations and rules therefore as required in the current manual of survey instructions of the United States Department of the Interior, Bureau of Land Management or by a decree of a Court of Law and/or that the corner points mentioned in lines 3, 4 and 5 above were in conformance with the rules of the Michigan Board of Land Surveyors or by a Decree of a Court of Law; established, re-established, monumented, re-monumented, recovered, found as expressed below:

NOTE: Not more than 4 corners, all in the same town and range, may be recorded on this certificate.


A	B	C	D	E	F	G	H	I	J	K	L	M
2	6	5	4	3	2	1						
3												
4	7	8	9	10	11	12						
5												
6	18	17	16	15	14	13						
7												
8	19	20	21	22	23	24						
9												
10	30	29	28	27	26	25						
11												
12	31	32	33	34	35	36						
13												

A. Description of original monument and accessories and/or subsequent restoration:
 L.C.R.C. L. 2 P. 371 1973 L.C.R.C. L. 6 P. 2 1989
 C-7 Found Flow point replaced with Cast Iron C-7 Set CIM
 mon. inscribed "Ottawa Co. Sec. Cor." SW cor. conc. pad SE 119.55'
 PP SE 129.27' 10' White Birch WNW 203.11'
 Tel. Pole SW 52.98' Street Sign NE 48.10'
 St. Sign SW 28.10' Stop Sign NW 44.87'
 SW cor. conc. pad NE 119.53'

B. Description of corner evidence found and/or method applied in restoring or reestablishing corner:
 C-7 Found Cast Iron Mon in Box
 SW cor. conc. pad NE 119.51'
 Nail S side 10" White Birch WNW 203.02'
 Street Sign NE 48.03'
 Stop Sign NW 44.90'

This marker is accepted as a careful and faithful perpetuation of the original corner.

C. Description of monument for corner and accessories established to perpetuate locating the position of the corner:
 C-7 Cast Iron Mon in Box (in centerline "X")
 Nail and O.C. Remon Tag W side P Pole S14°E 133.78'
 Nail and O.C. Remon Tag W side P Pole N7°E 206.11'
 Nail and O.C. Remon Tag NW side 10" Aspen N47°E 99.31'
 SW cor House #13641 Tyler St. (cut stone facing) N60°W 253.77'

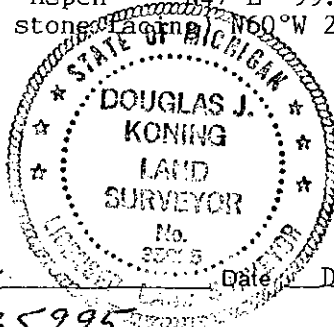

Signed by Douglas J. Koning Date December 6, 1993
Surveyor's Michigan License No. 35995