

**SURVEY &
REMONUMENTATION**

APR 25 1995

COMMISSION

For corners in

**OTTAWA COUNTY REMONUMENTATION
LAND CORNER RECORDATION CERTIFICATE**
Filing Requirement of Act 74, Mich. P.A. 1970


RECORDED

91 DEC -8 PM 12:36

Phyllis Robinson
REGISTER OF DEEDS
OTTAWA COUNTY, MI

<u>Ottawa</u> (County)	Located in:	Corner Code #
1. Public Land Survey	T <u>6N</u> R <u>15W</u>	<u>C-9</u> (SW cor., Sec. 20 Olive Twp.)
	T _____ R _____	_____
	T _____ R _____	_____
	T _____ R _____	_____
2. Property Controlling in Section	S _____ T _____ R _____	_____
	S _____ T _____ R _____	_____
3. Miscellaneous Property in Sec.	S _____ T _____ R _____	_____
	S _____ T _____ R _____	_____
4. Lot No. _____, Recorded Plat _____		
5. Private Claims _____		

Register of Deeds Stamp & File Number

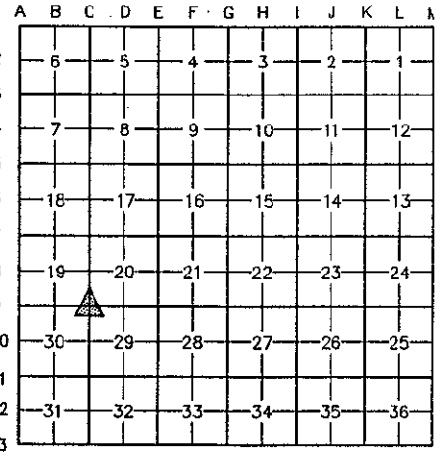

I, Douglas J. Koning, in a field survey on August 17, 1994
do hereby certify that under requirements of P.A. 74, Michigan P.A. of 1970, the corner points mentioned
in lines 1 and 2 above were in conformance with regulations and rules therefore as required in the
current manual of survey instructions of the United States Department of the Interior, Bureau of Land
Management or by a decree of a Court of Law and/or that the corner points mentioned in lines 3,4 and 5
above were in conformance with the rules of the Michigan Board of Land Surveyors or by a Decree of a
Court of Law; established, re-established, monumented, re-monumented, recovered, found as
expressed below:

**NOTE: Not more than 4 corners, all in the same town and range, may be recorded
on this certificate.**

A. Description of original monument and accessories and/of subsequent restoration:		
C-9 Government Notes Set Post May 1832 By Calvin Britain D.S. Birch 10" N78°E 15 Links B.Ash 8" N32°W 10 Links	L.C.R.C. Liber 1, Page 343, April 1972 C-9 Found Iron Pipe from old County Ties Nail in face 16" Maple NW 32.28' Nail in face Tel. Pole N 46.23' Nail in face 16" Maple SW 32.84' Nail in face 16" Maple NE 64.86' Nail in face Pwr pole NE 92.85'	L.C.R.C. Liber 5, Page 96, December 1983 C-9 Set cast iron Monument PP NE 97.99' 24" Maple WNW 81.06' 25" Maple SW 33.41' 23" Maple SE 65.54'

B. Description of corner evidence found and/or method applied in restoring or reestablishing corner.

C-9 Found Cast Iron Monument in Box
Nail NW side Pwr Pole NE 96.99'
Nail in NE side 24" Maple S50°E 65.92'


P.A. 345 OTTAWA COUNTY
PEER APPROVED 11/21/94

Douglas J. Koning

This marker is accepted as a careful and faithful perpetuation of the original corner.

C. Description of monument for corner and accessories established to perpetuate locating the position of the corner.

C-9 Cast Iron Monument (Centerline E-W Road)
O.C. Remon Tag & Nail NW side Pwr Pole S40°W 48.77'
O.C. Remon Tag & Nail Nly side 24" Maple S80°W 81.43'
O.C. Remon Tag & Nail NE side 24" Maple S60°E 65.74'
O.C. Remon NW side Pwr Pole N40°E 96.99'
4' W of Centerline Road to S
17' W of Centerline Road to W

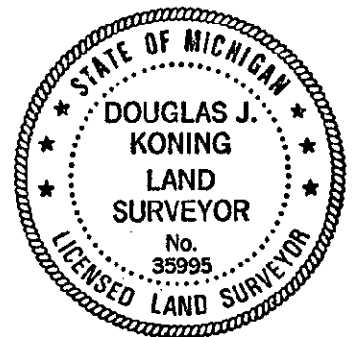

Signed by Douglas J. Koning
Surveyor's Michigan License No. 35995

Date November 14, 1994