

**OTTAWA COUNTY REMONUMENTATION
LAND CORNER RECORDATION CERTIFICATE**

For corners in

Filing Requirement of Act 74, Mich. P.A. 1970

RECORDED

<u>Ottawa</u> (County)	Located in:	Corner Code #
1. Public Land Survey	T 6N R 15W	C-10
	T _____ R _____	(E 1/4 cor., Sec. 30
	T _____ R _____	Olive Twp.)
	T _____ R _____	_____
2. Property Controlling in Section	S _____ T _____ R _____	_____
	S _____ T _____ R _____	_____
3. Miscellaneous Property in Sec.	S _____ T _____ R _____	_____
	S _____ T _____ R _____	_____
4. Lot No. _____, Recorded Plat _____		
5. Private Claims _____		

96 DEC 17 AM 10:41

D. J. Koning
REGISTER OF DEEDS
OTTAWA COUNTY, MI

Register of Deeds Stamp & File Number

A	B	C	D	E	F	G	H	I	J	K	L	M
2	6	5	4	3	2	1						
3												
4	7	8	9	10	11	12						
5												
6	18	17	16	15	14	13						
7												
8	19	20	21	22	23	24						
9												
10	30	29	28	27	26	25						
11												
12	31	32	33	34	35	36						
13												

I, Douglas J. Koning, in a field survey on November 8, 1996, do hereby certify that under requirements of P.A. 74, Michigan P.A. of 1970, the corner points mentioned in lines 1 and 2 above were in conformance with regulations and rules therefore as required in the current manual of survey instructions of the United States Department of the Interior, Bureau of Land Management or by a decree of a Court of Law and/or that the corner points mentioned in lines 3, 4 and 5 above were in conformance with the rules of the Michigan Board of Land Surveyors or by a Decree of a Court of Law; established, re-established, monumented, re-monumented, recovered, found as expressed below:

NOTE: Not more than 4 corners, all in the same town and range, may be recorded on this certificate.

A. Description of original monument and accessories and/of subsequent restoration:

C-10 Government Notes Set Post May 1832 By Calvin Britain D.S. Black Ash 8" S46°E 11 Links Leo 10" N58°W 17 Links	L.C.R.C. Liber 5, Page 305 March 1988 C-10 Cast Iron Monument S face Railroad sign N10°E 18.7' S face Telephone Pole S81°E 31.92' S face Power Pole N45°E 47.90' Ely Edge E rail W 5.25' N face Power Pole S45°W 57.18' E face Railroad sign W 25.17'	L.C.R.C. Liber 3, Page 210 November 1977 C-10 Set Cast Iron Monument Telephone Pole WSW 57.1' Centerline E rail WSW 5.3' Telephone Pole NE 48.05' Telephone Pole SE 31.94'
---	--	---

P.A. 345 OTTAWA COUNTY

PEER APPROVED 11-11-96

D. J. Koning

B. Description of corner evidence found and/or method applied in restoring or reestablishing corner.

C-10 Found Cast Iron Monument 1' deep
Ely edge E rail (Railroad) WSW 5.25'


This marker is accepted as a careful and faithful perpetuation of the original corner.

C. Description of monument for corner and accessories established to perpetuate locating the position of the corner.

C-10 Set 3/4" form pin & Remon Cap in Box (above Cast Iron Monument)
Set Remon Tag & Nail in NWly side Power Pole S22°W 213.28'
Set Remon Tag & Nail in SWly side Power Pole N59°W 226.29'
Set Remon Tag & Nail Sty end 60" CMP Culvert S66°E 49.79'
Easterly edge Railroad Rail (perpendicular measurement) S85°W 5.25'
5' South of centerline of Road to the East

\$ 9.00 CORNER
\$ 1.00 PHOTO

Signed by Douglas J. Koning
Surveyor's Michigan License No. 35995

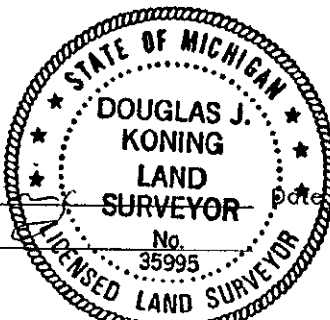

11-11-96