

**OTTAWA COUNTY REMONUMENTATION
LAND CORNER RECORDATION CERTIFICATE**

For corners in

Filing Requirement of Act 74, Mich. P.A. 1970

<u>Ottawa</u> (County)	Located in:	Corner Code #
1. Public Land Survey	T 6N R15W	C-11
	T _____ R _____	(SW cor., Sec. 29
	T _____ R _____	Olive Twp.)
	T _____ R _____	_____
2. Property Controlling in Section	S _____ T _____ R _____	_____
	S _____ T _____ R _____	_____
3. Miscellaneous Property in Sec.	S _____ T _____ R _____	_____
	S _____ T _____ R _____	_____
4. Lot No. _____, Recorded Plat _____		
5. Private Claims _____		

RECORDED

96 DEC 17 AM 10:41

Robert D. Hallman
REGISTER OF DEEDS
OTTAWA COUNTY, MI

Register of Deeds Stamp & File Number

	A	B	C	D	E	F	G	H	I	J	K	L	M
2	6		5		4		3		2		1		
3													
4	7		8		9		10		11		12		
5													
6	18		17		16		15		14		13		
7													
8	19		20		21		22		23		24		
9													
10	30		29		28		27		26		25		
11													
12	31		32		33		34		35		36		
13													

I, Douglas J. Koning, in a field survey on November 8, 1996, do hereby certify that under requirements of P.A. 74, Michigan P.A. of 1970, the corner points mentioned in lines 1 and 2 above were in conformance with regulations and rules therefore as required in the current manual of survey instructions of the United States Department of the Interior, Bureau of Land Management or by a decree of a Court of Law and/or that the corner points mentioned in lines 3, 4 and 5 above were in conformance with the rules of the Michigan Board of Land Surveyors or by a Decree of a Court of Law; established, re-established, monumented, re-monumented, recovered, found as expressed below:

NOTE: Not more than 4 corners, all in the same town and range, may be recorded on this certificate.

A. Description of original monument and accessories and/of subsequent restoration:

- | | | |
|-----------------------------|--|--|
| C-11 Government Notes | L.C.R.C. Liber 2, Page 85 March 1973 | L.C.R.C. Liber 5, Page 306 March 1988 |
| Set Post May 1832 | C-11 Found Steel Bar | C-11 Square Iron |
| By Calvin Britain D.S. | Found cross in pavement under blacktop | 12" Pine Tag #14091 NW 114.19' |
| Black Ash 8" S38°W 43 Links | 24" Maple N80°E 42.11' | 6" Pine SW 99.22' |
| Leo 6" N38°E 25 Links | Telephone Pole S45°W 64.62' | Pheasant, End of beak NW 118.73' |
| | Centerline Street Sign S45°W 41.09' | Power Pole NE 83.58' |
| | Power Pole N70°W 76.82' | L.C.R.C. Liber 3, Page 104 August 1976 |
| | Power Pole N45°E 83.26' | C-11 Square Steel Bar |
| | | Power Pole NW 76.78' |
| | | Power Pole NE 83.58' |
| | | Telephone Pole SW 64.27' |

B. Description of corner evidence found and/or method applied in restoring or reestablishing corner.

- C-11 Found Steel Bar (Top bent 0.25' to the SW, top appears to be square from wear on one side)
- Found Tag & Nail Wly side 16" Pine SW 99.53'
- Found Tag & Nail SE side Power Pole NE 83.20'
- Found Nail & Bot. Cap SE side Power Pole NE 83.20'
- Pheasant, end of beak NW 118.72'

P.A. 345 OTTAWA COUNTY
PEER APPROVED 11-11-96

M.D.N.


This marker is accepted as a careful and faithful perpetuation of the original corner.

C. Description of monument for corner and accessories established to perpetuate locating the position of the corner.

- C-11 Set 3/4" form pin & Remon cap (in Mon Box)
- Set Remon Tag & Nail in Wly side 16" Pine S35°W 99.47'
- Set Remon Tag & Nail in Sly side Power Pole N44°E 83.18'
- Set Remon Tag & Nail in Wly side Power Pole N35°W 79.59'
- Set Remon Tag & Nail in Ely side Power Pole S25°E 158.34'

\$ 9.00
\$ 1.00
CORNER
PHOTO

Signed by Douglas J. Koning
Surveyor's Michigan License No. 35995

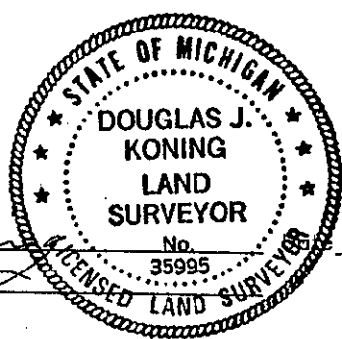

11-11-96