SURVEY & REMONUMENTATION

JUN 28 1999

SECTION

RECORDED

98 NOV -4 PM 2:30

REGISTER OF DEEDS
OTTAWA COUNTY, MI

OTTAWA COUNTY REMONUMENTATION

LAND CORNER RECORDATION CERTIFICATE

Filing Requirement of Act 74, Mich. P.A. 1970

For corners in OTTAWA (County)

Located In: Corner Code #

1. Public Land Survey — T 6N R 15W — C-13 SW Corner Sec 32 Olive Twp
2. Property Controlling in Section — S___ T___ R___
3. Miscellaneous Property in Sec. — S___ T___ R___

Register of Deeds Stamp & File Number

4. Lot No. _____, Recorded Plat _____
5. Private Claims _____

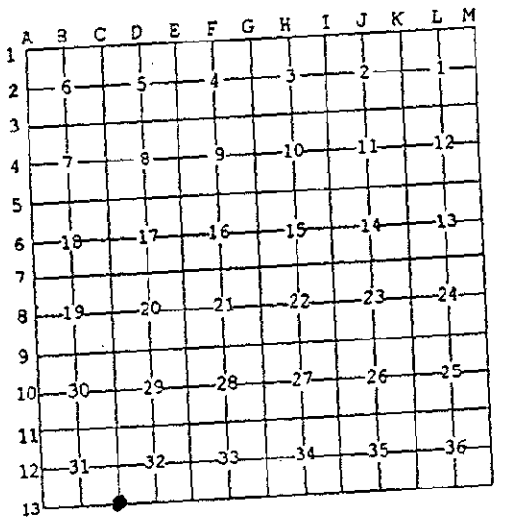

I, Randal J. Vugteveen, in a field survey on September 30, 19 98 do hereby state that under requirements of P.A. 74, Michigan P.A. of 1970, the corner points mentioned in lines 1 and 2 above were in conformance with regulations and rules therefore as required in the current manual of survey instructions of the United States Department of the Interior, Bureau of Land Management or by a decree of a Court of Law and /or that the corner points mentioned in lines 3, 4 and 5 above were in conformance with the rules of the Michigan Board of Land Surveyors or by a Decree of a Court of Law; established, re-established, monumented, recovered, found as expressed below:

NOTE: Not more than 2 corners, all in the same town and range, may be recorded on this certificate.

A. Description of original monument and accessories and/or subsequent restoration:

Remon Liber 3 Page 166
C-13 Cast Iron Monument (32' E of C.L. "X" & 4' S)
Remon Tag & Nail W side PP S20°W 44.27'
Remon Tag & Nail SE side Guy Pole N65°E 72.16'
Remon Tag & Nail S side PP N80°E 129.39'
Remon Tag & Nail S side PP S70°E 139.05'
Remon Tag & Nail N side PP S80°W 135.18'

B. Description of corner evidence found and/or method applied in restoring or reestablishing corner:

C-13 Found busted Cast Iron Monument 15" Long, Top 15" Below Grade.

Fnd Nail and Remon Tag W side PP S20°E 44.27'
Fnd Nail and Remon Tag
in Guy Pole N65°E 72.09'
Fnd Nail and Remon Tag in PP N80°E 129.34'
Fnd Nail and Remon Tag S side PP S70°E 139.00'
Fnd Nail and Remon Tag N side PP S80°E 135.20'
Fd Bar and Remon Cap in Mon. Box (on Town line)
N90°E 66.95'

Accepted Cast Iron Monument as a careful and faithful perpetuation of the position of the orginal corner.

Removed Cast Iron Monument and placed 3/4" X 36" Steel Bar and Remon Cap on Centerline Extended South and on Centerline E & W Road (Gravel)

10/19/98

C. Description of monument for corner and accessories established to perpetuate locating the position of the corner:

3/4" X 36" Steel Bar with Ottawa County Remon Cap

Found Nail and Remon Tag W side P Pole S20°E 44.27'
Found Nail and Remon Tag SE side Guy Pole N65°R 72.09'
Found Nail and Remon Tag SE side P. Pole N80°E 129.34'
Found Nail and Remon Tag S side P Pole S70°E 139.00'
Found Nail and Remon Tag N side P Pole S80°E 135.20'
Fd Bar and Remon Cap in Mon. Box (on Town line) N90°E 66.95'
On Centerline of E & W Gravel Road
On Centerline extended of Road to North

STATE OF MICHIGAN
RANDAL J. VUGTEVEEN
NO. 28429
LICENSED LAND SURVEYOR

49.00 CORNER
Receipt #18216
41.00 PHOTO
Receipt #18213

Signed by _____ Date October 19, 1998

Surveyor's Michigan License No. 28429

FORM APPROVED BY MICHIGAN STATE BOARD OF PROFESSIONAL SURVEYORS, JAN. 28, 1971
REVISED MAY 14, 1975
REVISED JAN., 1983
REVISED OCT., 1995

LIBER 004 PAGE 216