

RECORDED

96 DEC 18 PM 4: 55

OTTAWA COUNTY REMONUMENTATION
LAND CORNER RECORDATION CERTIFICATE

Filing Requirement of Act 74, Mich. P.A. 1970

REGISTER OF DEEDS
OTTAWA COUNTY, MI

For corners in

<u>Ottawa</u> (County)	Located in:	Corner Code #
1. Public Land Survey	T <u>6N</u> R <u>R15W</u>	D-1
	T _____ R _____	(N 1/4 cor., Sec. 5
	T _____ R _____	Olive Twp.)
	T _____ R _____	_____
2. Property Controlling in Section	S _____ T _____ R _____	_____
	S _____ T _____ R _____	_____
3. Miscellaneous Property in Sec.	S _____ T _____ R _____	_____
	S _____ T _____ R _____	_____
4. Lot No. _____, Recorded Plat _____		
5. Private Claims _____		

Register of Deeds Stamp & File Number

A	B	C	D	E	F	G	H	I	J	K	L	M
2	6	5	4	3	2	1						
3												
4	7	8	9	10	11	12						
5												
6	18	17	16	15	14	13						
7												
8	19	20	21	22	23	24						
9												
10	30	29	28	27	26	25						
11												
12	31	32	33	34	35	36						
13												

I, Douglas J. Koning, in a field survey on November 26, 1996, do hereby certify that under requirements of P.A. 74, Michigan P.A. of 1970, the corner points mentioned in lines 1 and 2 above were in conformance with regulations and rules therefore as required in the current manual of survey instructions of the United States Department of the Interior, Bureau of Land Management or by a decree of a Court of Law and/or that the corner points mentioned in lines 3, 4 and 5 above were in conformance with the rules of the Michigan Board of Land Surveyors or by a Decree of a Court of Law; established, re-established, monumented, re-monumented, recovered, found as expressed below:

NOTE: Not more than 4 corners, all in the same town and range, may be recorded on this certificate.

A. Description of original monument and accessories and/of subsequent restoration:

D-1 Government Notes Did not set	L.C.R.C. Liber 3, Page 208 November 1977 D-1 Set Cast Iron Monument Telephone Pole NE 50.50' 20" Maple SE 54.25' 15" Pepperidge SSE 36.60' Robinson Township Corner E 131.50'	L.C.R.C. Liber 6, Page 74 December 1990 D-1 Found Cast Iron Monument E 131.48' to Robinson corner SE 52.77' to Nail NW side 24" Maple SSE 36.64' to Nail & cap E side 16" Locust SW 65.65' to Nail N side 14" Cherry NW 28.62' to Nail SW side 10" Poplar
	L.C.R.C. Liber 6, Page 147 June 1991 D-1 Set Cast Iron Monument 24" Maple SE 53.33' 14" Oak S 36.63' Robinson corner E 131.53'	

PA. 345 OTTAWA COUNTY
PEER APPROVED 12-9-96
[Signature]

B. Description of corner evidence found and/or method applied in restoring or reestablishing corner.

D-1 Found Cast Iron Monument in Box 0.27' south of township line
 Found Nail & Tag #14091 East side 18" Tree S7°E 37.05'
 Found Nail SW side 30" Maple S54°E 53.51'
 Found Nail NW side 30" Maple S55°E 52.87'
 Found PK Nail in Bit. Road E 33.03'


This corner was not monumented by the original GLO survey. This monument is accepted as the best available evidence of the position of the corner.

C. Description of monument for corner and accessories established to perpetuate locating the position of the corner.

D-1 Established corner at the intersection of the N&S 1/4 line of Section 5, T6N, R15W, and the South line of Section 32, T7N, R15W.
 (Witnesses to point of Intersection)
 Cast iron monument in box South 0.27'
 Cast iron monument in box (D-13, T7N, R15W) East 131.44'
 Set Remon Tag & Nail in East side 16" Tree S7°E 36.99'
 Set Remon Tag & Nail in SW side 30" Maple S54°E 53.51'
 Set Remon Tag & Nail in SW side Power Pole N34°W 191.75'
 Set Remon Tag & Nail in W side Power Pole N33°E 182.81'
 NW corner Concrete Block House Foundation S66°E 216.62'
 Tree row to the South East 5'

(SEE SKETCH ON BACK)

Signed by Douglas J. Koning
Surveyor's Michigan License No. 35995

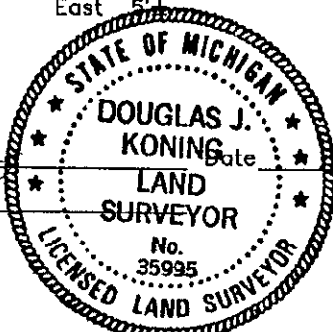

Date 12-9-96

SECTION 32, T7N, R15W
ROBINSON TOWNSHIP

SECTION 5, T6N, R15W
OLIVE TOWNSHIP

