

RECORDED

1993

OTTAWA COUNTY REMONUMENTATION  
LAND CORNER RECORDATION CERTIFICATE  
Filing Requirement of Act 74, Mich. P.A. 1970

93 DEC 15 AM 9:26

COMMISSION

*Douglas J. Koning*  
REGISTER OF DEEDS  
OTTAWA COUNTY, MI


For corners in

Ottawa (County)	Located In:	Corner Code #
1. Public Land Survey	T <u>6N</u> R <u>15W</u>	D-5
	T _____ R _____	(N1/4 Cor.,
	T _____ R _____	Sec. 17, Olive
	T _____ R _____	Twp.)
2. Property Controlling in Section	S _____ T _____ R _____	_____
	S _____ T _____ R _____	_____
3. Miscellaneous Property in Sec.	S _____ T _____ R _____	_____
	S _____ T _____ R _____	_____

Register of Deeds Stamp & File Number

4. Lot No. \_\_\_\_\_, Recorded Plat \_\_\_\_\_  
5. Private Claims \_\_\_\_\_

I, Douglas J. Koning, in a field survey on November 30, 19 93, do hereby certify that under requirements of P.A. 74, Michigan P.A. of 1970, the corner points mentioned in lines 1 and 2 above were in conformance with regulations and rules therefore as required in the current manual of survey instructions of the United States Department of the Interior, Bureau of Land Management or by a decree of a Court of Law and/or that the corner points mentioned in lines 3, 4 and 5 above were in conformance with the rules of the Michigan Board of Land Surveyors or by a Decree of a Court of Law; established, re-established, monumented, re-monumented, recovered, found as expressed below:

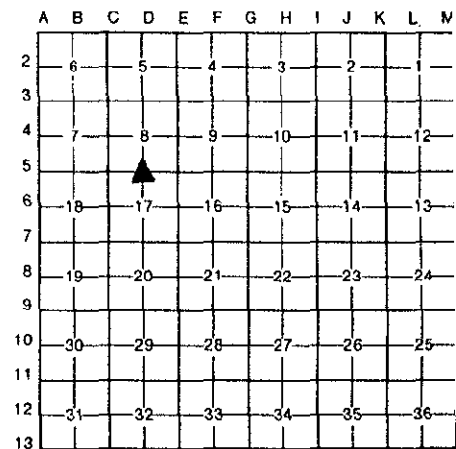

**NOTE: Not more than 4 corners, all in the same town and range, may be recorded on this certificate.**

A. Description of original monument and accessories and/or subsequent restoration:

L.C.R.C. L. 4 P 29 1980

D-5 Set Cast Iron Monument

New Ties Taken:

- Set Tie Nail In Side of Fence Post SE 47.06'
- Set Tie Nail in Side of Fence Post South 33.03'
- Set Tie Nail in Side of Fence Post NW 40.06'
- Set Tie Nail in Side of Fence Post NE 36.84'
- Center Line Existing Road North 11'±
- Lane to the North

B. Description of corner evidence found and/or method applied in restoring or reestablishing corner:

D-5 Found Cast Iron Monument

- Nail & Cap NE Side of Fence Post SE 47.05'
- Nail & Cap East Side of Fence Post South 33.02'


This marker is accepted as a careful and faithful perpetuation of the original corner.

C. Description of monument for corner and accessories established to perpetuate locating the position of the corner:

D-5 Cast Iron Monument (12'± S of Center Line E-W Road)

Capped Iron (#21272)

- Set Nail and O.C. Remon Tag in SW Side of 10" Pine North 9.74'
- Set Nail and O.C. Remon Tag in E Side of 12' Pine N30°W 65.49'
- Set Nail and O.C. Remon Tag in N side of 14' Twin Cherry N30°E 55.12'
- Set Nail and O.C. Remon Tag in W side of Triple Cherry S80°E 58.70'
- Set Nail and O.C. Remon Tag in W side of Triple Cherry S20°W 72.17'

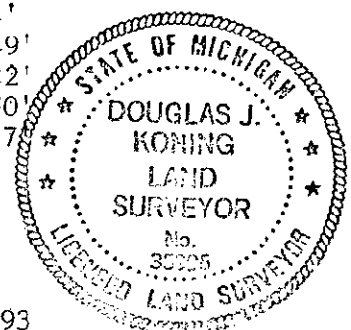

Signed by Douglas J. Koning Date December 6, 1993  
Surveyor's Michigan License No. 35995