

SURVEY & REMONUMENTATION

APR 25 1995

COMMISSION OTTAWA COUNTY REMONUMENTATION LAND CORNER RECORDATION CERTIFICATE

RECORDED

94 DEC -8 PM 12:37

For corners in

Filing Requirement of Act 74, Mich. P.A. 1970

D. J. Koning
REGISTER OF DEEDS
OTTAWA COUNTY, MI

<u>Ottawa</u> (County)	Located in:	Corner Code #
1. Public Land Survey	T <u>6N</u> R <u>15W</u>	D-9
	T _____ R _____	(S 1/4 cor., Sec.
	T _____ R _____	20, Olive Twp.)
	T _____ R _____	_____
2. Property Controlling in Section	S _____ T _____ R _____	_____
	S _____ T _____ R _____	_____
3. Miscellaneous Property in Sec.	S _____ T _____ R _____	_____
	S _____ T _____ R _____	_____
4. Lot No. _____, Recorded Plat _____		
5. Private Claims _____		

Register of Deeds Stamp & File Number

	A	B	C	D	E	F	G	H	I	J	K	L	M
2	6	5	4	3	2	1							
3													
4	7	8	9	10	11	12							
5													
6	18	17	16	15	14	13							
7													
8	19	20	21	22	23	24							
9													
10	30	29	28	27	26	25							
11													
12	31	32	33	34	35	36							
13													

I, Douglas J. Koning in a field survey on September 28, 1994, do hereby certify that under requirements of P.A. 74, Michigan P.A. of 1970, the corner points mentioned in lines 1 and 2 above were in conformance with regulations and rules therefore as required in the current manual of survey instructions of the United States Department of the Interior, Bureau of Land Management or by a decree of a Court of Law and/or that the corner points mentioned in lines 3, 4 and 5 above were in conformance with the rules of the Michigan Board of Land Surveyors or by a Decree of a Court of Law; established, re-established, monumented, re-monumented, recovered, found as expressed below:

NOTE: Not more than 4 corners, all in the same town and range, may be recorded on this certificate.

A. Description of original monument and accessories and/of subsequent restoration:

D-9 Government Notes Set Post May 1832 By Calvin Britain D.S. Elm 8" S88°W 10 Links Hemlock 9" N88°E 30 Links	L.C.R.C. Liber 2, Page 371, November 1973 D-9 Found Iron in Monument Box	L.C.R.C. Liber 5, Page 96, December 1983 D-9 Found Angle iron in Mon. Box 20" Maple SW 64.96' 28" Maple SW 117.49' 25" Maple WSW 175.79'
	L.C.R.C. Liber 3, Page 385, July 1979 D-9 Angle Iron in Monument Box N70°W 18" Maple 57.21' S45°W 14" Maple 64.6' S60°W 20" Maple 117.98'	

3. Description of corner evidence found and/or method applied in restoring or reestablishing corner.

D-9 Found cast iron monument in Mon. Box
Nail in N side 26" Maple SW 64.61'
Nail in SE side 34" Maple SW 117.12'
Nail in N side 36" Maple WSW 176.15'


P.A. 345 OTTAWA COUNTY
PEER APPROVED 11/21/94

Maday D. Tidewell

This marker is accepted as a careful and faithful perpetuation of the original corner.

C. Description of monument for corner and accessories established to perpetuate locating the position of the corner.

D-9 Cast iron monument in Mon. Box (On centerline Port Sheldon Rd)
Set O.C. Remon Tag & Nail in SE side 48" Maple S82°09'W 286.47'
Set O.C. Remon Tag & Nail in N side 36" Maple S77°40'W 176.05'
Set O.C. Remon Tag & Nail in SE side 34" Maple S70°02'W 117.14'
Set O.C. Remon Tag & Nail in N side 26" Maple S53°48'W 64.29'

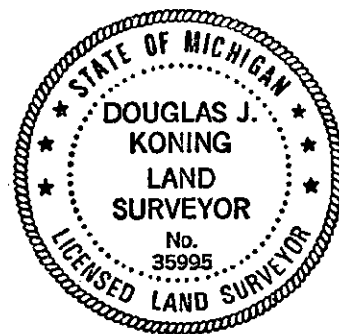

Signed by Douglas J. Koning
Surveyor's Michigan License No. 35995

Date November 14, 1994