

SURVEY & REMONUMENTATION

APR 05 1996

COMMISSION

OTTAWA COUNTY REMONUMENTATION

LAND CORNER RECORDATION CERTIFICATE

Filing Requirement of Act 74, Mich. P.A. 1970

RECORDED

95 DEC 12 PM 4:52

Douglas J. Koning
REGISTER OF DEEDS
OTTAWA COUNTY, MI

For corners in

Ottawa (County)	Located in:	Corner Code #
1. Public Land Survey	T <u>6N</u> R <u>15W</u>	D-11 (S 1/4 cor., Sec. 29 Olive Twp.)
	T _____ R _____	_____
	T _____ R _____	_____
	T _____ R _____	_____
2. Property Controlling in Section	S _____ T _____ R _____	_____
	S _____ T _____ R _____	_____
3. Miscellaneous Property in Sec.	S _____ T _____ R _____	_____
	S _____ T _____ R _____	_____
4. Lot No. _____, Recorded Plat _____		
5. Private Claims _____		

Register of Deeds Stamp & File Number

	A	B	C	D	E	F	G	H	I	J	K	L	M
2	6	5	4	3	2								
3													
4	7	8	9	10	11	12							
5													
6	18	17	16	15	14	13							
7													
8	19	20	21	22	23	24							
9													
10	30	29	28	27	26	25							
11													
12	31	32	33	34	35	36							
13													

I, Douglas J. Koning, in a field survey on November 22, 1995, do hereby certify that under requirements of P.A. 74, Michigan P.A. of 1970, the corner points mentioned in lines 1 and 2 above were in conformance with regulations and rules therefore as required in the current manual of survey instructions of the United States Department of the Interior, Bureau of Land Management or by a decree of a Court of Law and/or that the corner points mentioned in lines 3, 4 and 5 above were in conformance with the rules of the Michigan Board of Land Surveyors or by a Decree of a Court of Law; established, re-established, monumented, re-monumented, recovered, found as expressed below:

NOTE: Not more than 4 corners, all in the same town and range, may be recorded on this certificate.

A. Description of original monument and accessories and/of subsequent restoration:

D-11 Government Notes Calvin Britain D.S. Set Post May 1832 Hemlock 12" N60°W 10 Links Birch 14" S54°E 26 Links	L.C.R.C. Liber 3, Page 104 August 1976 D-11 Iron Rod Elm stump S 35.73' Power Pole NE 77.20' Street Sign NE 50.50' Hole in culvert NW 37.25' Hole in Culvert NE 39.15'	L.C.R.C. Liber 3, Page 211 November 1977 D-11 Set Cast Iron Monument over Iron Pipe Power Pole NE 75' Centerline Street Sign NE 50' 12" Ash NNE 114' Centerline E End Culvert NE 39.22'
---	--	---

L.C.R.C. Liber 1, Page 41 June 1971

D-11 Steel Bar Nail in Elm Stump S 35.73' Nail in Power Pole NE 77.20' Centerline Street Sign NE 50.55' 1/2" Drill Hole in top of 36" Concrete Culvert NW 37.25' 1/2" Drill Hole in top of 36" Concrete Culvert NE 39.15'
--

B. Description of corner evidence found and/or method applied in restoring or reestablishing corner.

D-11 Found Cast Iron Monument (1" below surface Gravel Road) Found Hole in Top conc. culvert (E. end) NE 39.29' Found Hole in Top conc. culvert (W. end) NW 37.51' Centerline Street Sign NE 50.64'
--

OTTAWA COUNTY


PEER APPROVED 12/11/95

Maday D. Newell

This marker is accepted as a careful and faithful perpetuation of the original corner.

C. Description of monument for corner and accessories established to perpetuate locating the position of the corner.

D-11 Cast Iron Monument (4' S & 1.5' W of Centerline "X" of Roads) Set Remon Tag & Nail in SE side Power Pole N40°E 60.47' Set Remon Tag & Nail in W side 18" Ash N10°E 114.68' Cut "X" on Drill hole E end Concrete Culvert N30°E 39.29' Cut "X" on Drill hole W end Concrete Culvert N15°W 37.51' Found 1" Pipe Bent & Leaning N75°W 8'±

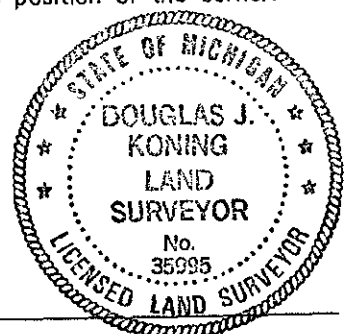

Signed by Douglas J. Koning
Surveyor's Michigan License No. 35995

Date 12-11-95