

**SURVEY & REMONUMENTATION**

APR 05 1996

RECORDED

COMMISSION OTTAWA COUNTY REMONUMENTATION 95 DEC 12 PM 4:52

LAND CORNER RECORDATION CERTIFICATE

Filing Requirement of Act 74, Mich. P.A. 1970

REGISTER OF DEEDS  
OTTAWA COUNTY, MI

For corners in

Ottawa (County)	Located in:	Corner Code #
1. Public Land Survey	T 6N R15W	D-13
	T R	(S 1/4 cor., Sec. 32
	T R	Olive Twp.)
	T R	
2. Property Controlling in Section	S T R	
	S T R	
3. Miscellaneous Property in Sec.	S T R	
	S T R	
4. Lot No. _____, Recorded Plat _____		
5. Private Claims _____		

Register of Deeds Stamp & File Number

	A	B	C	D	E	F	G	H	I	J	K	L	M
2	6	5	4	3	2								
3													
4	7	8	9	10	11	12							
5													
6	18	17	16	15	14	13							
7													
8	19	20	21	22	23	24							
9													
10	30	29	28	27	26	25							
11													
12	31	32	33	34	35	36							
13													

I, Douglas J. Koning, in a field survey on November 21, 1995, do hereby certify that under requirements of P.A. 74, Michigan P.A. of 1970, the corner points mentioned in lines 1 and 2 above were in conformance with regulations and rules therefore as required in the current manual of survey instructions of the United States Department of the Interior, Bureau of Land Management or by a decree of a Court of Law and/or that the corner points mentioned in lines 3, 4 and 5 above were in conformance with the rules of the Michigan Board of Land Surveyors or by a Decree of a Court of Law; established, re-established, monumented, re-monumented, recovered, found as expressed below:

NOTE: Not more than 4 corners, all in the same town and range, may be recorded on this certificate.

A. Description of original monument and accessories and/of subsequent restoration:

D-13 Government Notes Set Post May 1832 Pine 1" N71°E 17 Links Leo 18" N66°W 44 Links Calvin Britain D.S.	L.C.R.C. Liber 2, Page 85 March 1973 D-13 Found Iron Pipe Holland Co. (iron) E 71.10' 14" Sassafras SW 82.25' 14" Sassafras SW 54.18' Power Pole SE 124.77' SW Bridge Post SE 43.28' NW Bridge Post NE 43.12'	L.C.R.C. Liber 3, Page 210 Nov. 1977 D-13 Set Cast Iron Monument over Iron Pipe 15" Catalpa SW 54.57' 18" Willow SE 78.96' Holland Corner E 71.10'
L.C.R.C. Liber 3, Page 280 Aug. 1978 D-13 Iron Pipe Holland Co. (iron) E 71.10' 14" Sassafras SW 82.25' 14" Sassafras SW 54.18' Power Pole SE 124.77' SW Bridge Post SE 43.28' NW Bridge Post NE 43.12' Centerline Hydrant N20°W 47.06'	L.C.R.C. Liber 3, Page 321 Jan. 1979 D-13 Found Iron Pipe Holland Co. (iron) E 71.10' 14" Sassafras SW 82.25' 14" Sassafras SW 54.18' Power Pole SE 124.77' SW Bridge Post SE 43.28' NW Bridge Post NE 43.12' Centerline Hydrant N20°W 47.06'	L.C.R.C. Liber 3, Page 365 July 1979 D-13 Iron Pipe Holland Co. (iron) E 71.10' 14" Sassafras SW 82.25' 14" Sassafras SW 54.18' Power Pole SE 124.77' Nail in SW Bridge Post SE 43.28' Nail in NW Bridge Post NE 43.12' Centerline Hydrant N20°W 47.06'

B. Description of corner evidence found and/or method applied in restoring or reestablishing corner.

D-13 Found Cast Iron Monument in Box (1' deep)  
Found Square Spike NE side 18" Catalpa 54.24'  
Centerline 50" Willow SE 78.8'  
Centerline Hydrant NNW 47.03'  
Found Cast Iron Monument in Box E 71.01'  
Centerline 20" Osage Orange SW 83.24'

P.A. 345 OTTAWA COUNTY

PEER APPROVED


12/11/95

*Douglas J. Koning*  
*DJK*

This marker is accepted as a careful and faithful perpetuation of the original corner.

C. Description of monument for corner and accessories established to perpetuate locating the position

D-13 Set 3/4" Pin and Ottawa County Remon cap above Cast Iron Monument  
Set Remon Tag & Nail E side Power Pole S10°E 127.00'  
Set Remon Tag & Nail NW corner Wood Bridge Deck N70°E 47.72'  
Set Remon Tag & Nail SW corner Wood Bridge Deck S60°E 48.15'  
Set Remon Tag & Nail NW side 18" Catalpa S65°W 54.20'

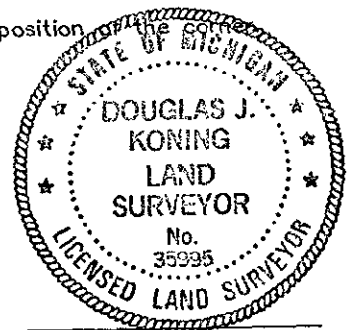

Signed by Douglas J. Koning  
Surveyor's Michigan License No. 35995

Date 12-11-95