

RECORDED

RECORDED

1993
COMMISSION

OTTAWA COUNTY REMONUMENTATION
LAND CORNER RECORDATION CERTIFICATE
Filing Requirement of Act 74, Mich. P.A. 1970


93 DEC 15 AM 9:26

Douglas J. Koning
REGISTER OF DEEDS
OTTAWA COUNTY, MI

| For corners in Ottawa (County) | Located In: | Corner Code # |
|---------------------------------------|-------------------------|-----------------|
| 1. Public Land Survey | T 6N R 15W | E-5 |
| | T _____ R _____ | (NE cor. Sec. |
| | T _____ R _____ | 17, Olive Twp.) |
| | T _____ R _____ | _____ |
| 2. Property Controlling in Section | S _____ T _____ R _____ | _____ |
| | S _____ T _____ R _____ | _____ |
| 3. Miscellaneous Property in Sec. | S _____ T _____ R _____ | _____ |
| | S _____ T _____ R _____ | _____ |
| 4. Lot No. _____, Recorded Plat _____ | | |
| 5. Private Claims _____ | | |

Register of Deeds Stamp & File Number

I, Douglas J. Koning, in a field survey on Nov. 20, 1993, do hereby certify that under requirements of P.A. 74, Michigan P.A. of 1970, the corner points mentioned in lines 1 and 2 above were in conformance with regulations and rules therefore as required in the current manual of survey instructions of the United States Department of the Interior, Bureau of Land Management or by a decree of a Court of Law and/or that the corner points mentioned in lines 3, 4 and 5 above were in conformance with the rules of the Michigan Board of Land Surveyors or by a Decree of a Court of Law; established, re-established, monumented, re-monumented, recovered, found as expressed below:

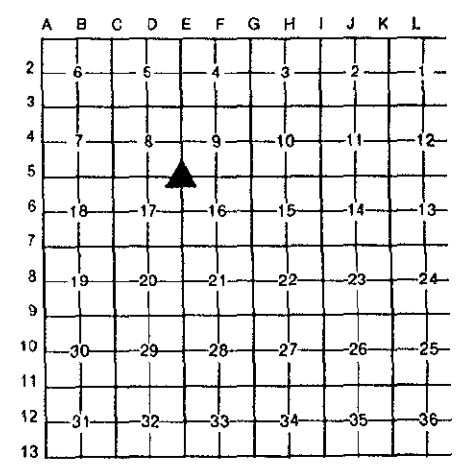

NOTE: Not more than 4 corners, all in the same town and range, may be recorded on this certificate.

| A. Description of original monument and accessories and/or subsequent restoration: | | | |
|--|-----------------|-------------------------|-----------|
| L.C.R.C. L.2 P.709 1974 | | L.C.R.C. L.3 P.146 1977 | |
| E-5 12" Tree | N21°30'E 64.00' | E-5 Cast Iron Mon. | |
| 10" Sassafras | N33°W 26.00' | Center Line sign | SE 49.40' |
| 14" Sassafras | S19°W 46.35' | P. Pole | SE 48.12' |
| P. Pole | S45°E 48.09' | 10" Sassafras | SSW45.85' |
| Road Sign Post | S54°30'E 42.40' | 10" Pepperridge | NNR63.98' |

B. Description of corner evidence found and/or method applied in restoring or reestablishing corner:

| | | | |
|-------------------------|---------------|-------|--------|
| E-5 Found Cast Iron Mon | | | |
| Nail W.side | 14" Tree | N21°E | 63.98' |
| Nail & Tag E.side | 12" Sassafras | N25°W | 77.06' |
| Nail in P.Pole | | S45°E | 48.14' |

This marker is accepted as a careful and faithful perpetuation of the original corner.

C. Description of monument for corner and accessories established to perpetuate locating the position of the corner:

OTTAWA COUNTY REMONUMENTATION OLIVE TOWNSHIP

| | | | |
|-----|--|-------|--------|
| E-5 | Cast Iron Mon. (in center line "x" rds.) | | |
| | Nail & Ottawa County Remonument tag | | |
| | NE side P.Pole | S43°E | 48.06' |
| | E side 12" Sassafras | S25°W | 77.06' |
| | NE side 10" Oak | N58°W | 49.55' |
| | W side 14" Tree | N21°E | 63.94' |



Signed by Douglas J. Koning Date December 6, 1993
Surveyor's Michigan License No. 35995