

RECORDED

1237

OTTAWA COUNTY REMONUMENTATION  
LAND CORNER RECORDATION CERTIFICATE  
Filing Requirement of Act 74, Mich. P.A. 1970

RECORDED

93 DEC 15 AM 9:26

COMMISSION

*Daphne Williams*  
REGISTER OF DEEDS  
OTTAWA COUNTY, MI


For corners in

Ottawa (County)	Located In:	Corner Code #
1. Public Land Survey	T <u>6N</u> R <u>15W</u>	<u>E-7</u>
	T _____ R _____	(SE Cor. Sec.
	T _____ R _____	<u>17, Olive Twp.</u> )
	T _____ R _____	_____
2. Property Controlling in Section	S _____ T _____ R _____	_____
	S _____ T _____ R _____	_____
3. Miscellaneous Property in Sec.	S _____ T _____ R _____	_____
	S _____ T _____ R _____	_____

Register of Deeds Stamp & File Number

4. Lot No. \_\_\_\_\_, Recorded Plat \_\_\_\_\_  
5. Private Claims \_\_\_\_\_

I, Douglas J. Koning, in a field survey on November 30, 19 93, do hereby certify that under requirements of P.A. 74, Michigan P.A. of 1970, the corner points mentioned in lines 1 and 2 above were in conformance with regulations and rules therefore as required in the current manual of survey instructions of the United States Department of the Interior, Bureau of Land Management or by a decree of a Court of Law and/or that the corner points mentioned in lines 3, 4 and 5 above were in conformance with the rules of the Michigan Board of Land Surveyors or by a Decree of a Court of Law; established, re-established, monumented, re-monumented, recovered, found as expressed below:

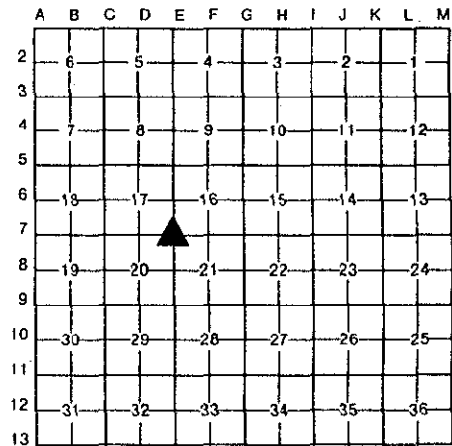

**NOTE: Not more than 4 corners, all in the same town and range, may be recorded on this certificate.**

A. Description of original monument and accessories and/or subsequent restoration:

L.C.R.C. L. 1 P. 781	1972	L.C.R.C. L. 2 P. 709	1974
E-7 Found angle iron		E-7 26" Maple	N60°E 36.91'
Set cast iron mounument		St Sign Post	S45°E 37.45'
Nail in Face of 24" Maple	N45°W 34.88'	20" Maple	N55°W 34.91'
Nail in Face of 20" Maple	N35°W 57.78'	18" Maple	N40°W 57.78'
Nail in Face of 30" Maple	N55°E 36.85'		
Centerline St Sign	SE 37.45'		

B. Description of corner evidence found and/or method applied in restoring or reestablishing corner:

E-7 Found Cast Iron Monument


Center of Stump	NW	57.43'
Nail in Face 34" Maple	NE	36.80'
24" Maple	N40°W	35.35'
Nail & Tag S. side 24" Maple	NNE	50.95'
PK N. side Power Pole	S70°E	85.52'

This marker is accepted as a careful and faithful perpetuation of the original corner.

C. Description of monument for corner and accessories established to perpetuate locating the position of the corner:

E-7 Cast Iron Monument (3' N. of Centerline "X", 1.1' Deep)

Set Nail and O.C. Remon Tag NE side 24" Maple	N40°W	36.06'
Set Nail and O.C. Remon Tag W side 24" Maple	N30°E	51.77'
Set Nail and O.C. Remon Tag S side 34" Maple	N65°E	38.27'
Set Nail and O.C. Remon Tag N side P. Pole	S70°E	85.54'

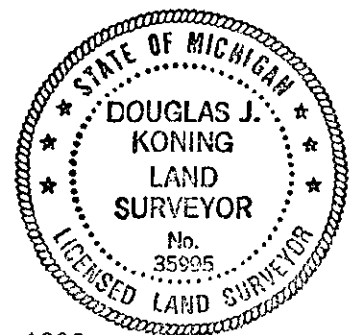

Signed by *Douglas J. Koning* Date December 6, 1993  
Surveyor's Michigan License No. 35995