

# SURVEY & REMONUMENTATION

APR 25 1995

OTTAWA COUNTY REMONUMENTATION

COMMISSION

LAND CORNER RECORDATION CERTIFICATE

For corners in

Filing Requirement of Act 74, Mich. P.A. 1970

RECORDED

94 DEC -8 PM 12:37

*D. J. ...*  
REGISTER OF DEEDS  
OTTAWA COUNTY, MI

<u>Ottawa</u> (County)	Located in:	Corner Code #
1. Public Land Survey	T <u>6N</u> R <u>15W</u>	E-8
	T _____ R _____	(E 1/4 cor., Sec.
	T _____ R _____	20, Olive Twp.)
	T _____ R _____	
2. Property Controlling in Section	S _____ T _____ R _____	<i>Log. # 2 pm</i>
	S _____ T _____ R _____	
3. Miscellaneous Property in Sec.	S _____ T _____ R _____	
	S _____ T _____ R _____	
4. Lot No. _____, Recorded Plat _____		
5. Private Claims _____		

Register of Deeds Stamp & File Number

A	B	C	D	E	F	G	H	I	J	K	L	M
2	6	5	4	3	2	1						
3												
4	7	8	9	10	11	12						
5												
6	18	17	16	15	14	13						
7												
8	19	20	21	22	23	24						
9												
10	30	29	28	27	26	25						
11												
12	31	32	33	34	35	36						
13												

I, Douglas J. Koning, in a field survey on August 17, 1994, do hereby certify that under requirements of P.A. 74, Michigan P.A. of 1970, the corner points mentioned in lines 1 and 2 above were in conformance with regulations and rules therefore as required in the current manual of survey instructions of the United States Department of the Interior, Bureau of Land Management or by a decree of a Court of Law and/or that the corner points mentioned in lines 3, 4 and 5 above were in conformance with the rules of the Michigan Board of Land Surveyors or by a Decree of a Court of Law; established, re-established, monumented, re-monumented, recovered, found as expressed below:

NOTE: Not more than 4 corners, all in the same town and range, may be recorded on this certificate.

A. Description of original monument and accessories and/of subsequent restoration:

E-8 Government Notes Set Post May 1832 By Calvin Britain D.S. Elm 12" S15°E 22 Links Maple 18" N15°W 25 Links	L.C.R.C. Liber 1, Page 781, December 1972 E-8 Found axle over stone "X" in culvert SE 28.84' "X" in culvert NE 21.62' "X" in culvert NW 26.00' Tel. Pole SW 47.94' Street Sign SW 38.03'	L.C.R.C. Liber 2, Page 371, November 1873 E-8 Found cross on stone with iron above Street Sign SW 38.2' "X" in culvert NE 21.81' "X" in culvert SE 28.81' "X" in culvert NW 26.11'
	L.C.R.C. Liber 3, Page 385, July 1979 E-8 Cast Iron Monument SW Street Sign 37.9' NE "X" on Culvert 21.81' SE "X" on Culvert 28.81' NW "X" on Culvert 26.11'	

B. Description of corner evidence found and/or method applied in restoring or reestablishing corner.

E-8 Found Cast Iron Monument

Found "X" Cut on Conc. Culvert	N40°E 21.90'
Found "X" Cut on Conc. Culvert	N45°W 26.12'
Found "X" Cut on Conc. Culvert	S45°E 28.88'

P.A. 345 OTTAWA COUNTY

PEER APPROVED 11/21/94


*Madison D. McDowell*

This marker is accepted as a careful and faithful perpetuation of the original corner.

C. Description of monument for corner and accessories established to perpetuate locating the position of the corner.

E-8 Cast Iron Monument (6' N of centerline "X" of crossroads)

O.C. Remon Tag & Nail S Side Pwr Pole	N82°E 92.53'
O.C. Remon Tag & Nail SW Side Pwr Pole	N58°W 148.34'
"X" Cut on Conc. Culvert	N40°E 21.90'
"X" Cut on Conc. Culvert	N45°W 26.12'
"X" Cut on Conc. Culvert	S45°E 28.88'

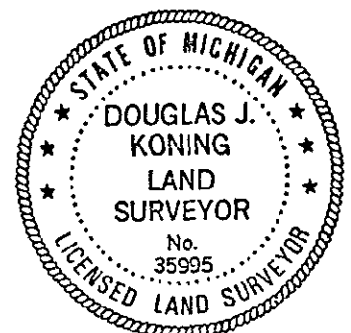

Signed by Douglas J. Koning  
Surveyor's Michigan License No. 35995

Date November 14, 1994