

**SURVEY &
REMONUMENTATION**

APR 05 1996

COMMISSION

**OTTAWA COUNTY REMONUMENTATION
LAND CORNER RECORDATION CERTIFICATE**

RECORDED

95 DEC 12 PM 4: 52

Richard A. Johnson
REGISTER OF DEEDS
OTTAWA COUNTY, MI

For corners in

Filing Requirement of Act 74, Mich. P.A. 1970

Ottawa (County)	Located in:	Corner Code #
1. Public Land Survey	T 6N R15W	E-10
	T _____ R _____	(E 1/4 cor., Sec. 29
	T _____ R _____	Olive Twp.)
	T _____ R _____	
2. Property Controlling in Section	S _____ T _____ R _____	
	S _____ T _____ R _____	
3. Miscellaneous Property in Sec.	S _____ T _____ R _____	
	S _____ T _____ R _____	
4. Lot No. _____, Recorded Plat _____		
5. Private Claims _____		

Register of Deeds Stamp & File Number

	A	B	C	D	E	F	G	H	I	J	K	L	M
2	6	5	4	3	2	1							
3													
4	7	8	9	10	11	12							
5													
6	18	17	16	15	14	13							
7													
8	19	20	21	22	23	24							
9													
10	30	29	28	27	26	25							
11													
12	31	32	33	34	35	36							
13													

I, Douglas J. Koning, in a field survey on December 7, 1995, do hereby certify that under requirements of P.A. 74, Michigan P.A. of 1970, the corner points mentioned in lines 1 and 2 above were in conformance with regulations and rules therefore as required in the current manual of survey instructions of the United States Department of the Interior, Bureau of Land Management or by a decree of a Court of Law and/or that the corner points mentioned in lines 3,4 and 5 above were in conformance with the rules of the Michigan Board of Land Surveyors or by a Decree of a Court of Law; established, re-established, monumented, re-monumented, recovered, found as expressed below:

NOTE: Not more than 4 corners, all in the same town and range, may be recorded on this certificate.

A. Description of original monument and accessories and/of subsequent restoration:

F-11 Government Notes	E-10 Set Cast Iron Monument
Set Post May 1832	Power Pole SE 76.32'
Beech 14" S5°W 9 Links	Centerline Street Sign SE 38.1'
Maple 16" N5°W 24 Links	8" Hickory SE 44.5'
Calvin Britain D.S.	

B. Description of corner evidence found and/or method applied in restoring or reestablishing corner.

E-10 Found Cast Iron Monument	
Found Nail in Sw side 10" Hickory	SE 44.49'
Found Nail NE side Power Pole	SE 76.25'
Found Nail W side Power Pole	NNE 171.78'


PA. 345 OTTAWA COUNTY
PEER APPROVED 12/11/95

Richard D. Redwood RDM

This marker is accepted as a careful and faithful perpetuation of the original corner.

C. Description of monument for corner and accessories established to perpetuate locating the position of the corner.

E-10 Cast Iron Monument (in Centerline "X" of Roads)	
Set Remon Tag & Nail in SW side Power Pole	S45°E 75.98'
Set Remon Tag & Nail in SW side 10" Hickory	S55°E 44.50'
Set Remon Tag & Nail in W side Power Pole	N20°E 171.79'
Set Remon Tag & Nail in S side 18" Maple	N75°W 142.18'
SE corner Concrete Block Porch Foundation House #12931 Bigham	N70°W 186.77'

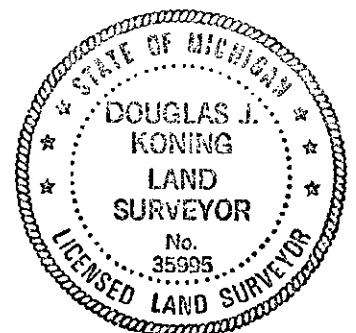

Signed by Douglas J. Koning

Date 12-11-95

Surveyor's Michigan License No. 35995