

**SURVEY & REMONUMENTATION**

JUN 28 1999

**SECTION**

**OTTAWA COUNTY REMONUMENTATION  
LAND CORNER RECORDATION CERTIFICATE**

**RECORDED**

98 NOV -4 PM 2:31

*Doug Koning*  
REGISTER OF DEEDS  
OTTAWA COUNTY, MI

For corners in

Filing Requirement of Act 74, Mich. P.A. 1970

<u>Ottawa</u> (County)	Located in:	Corner Code #
1. Public Land Survey	T <u>6N</u> R <u>15W</u>	F-1 (N 1/4 cor., Sec. 4 Olive Twp.)
	T _____ R _____	_____
	T _____ R _____	_____
	T _____ R _____	_____
2. Property Controlling in Section	S _____ T _____ R _____	_____
	S _____ T _____ R _____	_____
3. Miscellaneous Property in Sec.	S _____ T _____ R _____	_____
	S _____ T _____ R _____	_____
4. Lot No. _____, Recorded Plat _____		
5. Private Claims _____		

Register of Deeds Stamp & File Number

	A	B	C	D	E	F	G	H	I	J	K	L	M
2	6	5	4	3	2	1							
3													
4	7	8	9	10	11	12							
5													
6	18	17	16	15	14	13							
7													
8	19	20	21	22	23	24							
9													
10	30	29	28	27	26	25							
11													
12	31	32	33	34	35	36							
13													

I, Douglas J. Koning, in a field survey on October 5, 1998, do hereby certify that under requirements of P.A. 74, Michigan P.A. of 1970, the corner points mentioned in lines 1 and 2 above were in conformance with regulations and rules therefore as required in the current manual of survey instructions of the United States Department of the Interior, Bureau of Land Management or by a decree of a Court of Law and/or that the corner points mentioned in lines 3, 4 and 5 above were in conformance with the rules of the Michigan Board of Land Surveyors or by a Decree of a Court of Law; established, re-established, monumented, re-monumented, recovered, found as expressed below:

NOTE: Not more than 4 corners, all in the same town and range, may be recorded on this certificate.

**A. Description of original monument and accessories and/of subsequent restoration:**

F-1 Government Notes did not set	L.C.R.C. Liber 5, Page 87 December 1983 F-1 Set Cast Iron Monument 24" White Pine NNW 68.52' 8" Oak SW 48.30' 10" Red Pine SE 51.38' Robinson Township corner E 66.50'	L.C.R.C. Liber 6, Page 146 June 1991 F-1 Raised Cast Iron Monument 24" White Pine NNW 69.34' Twin Oak WSW 48.29' 10" Red Pine SE 65.06' Robinson Corner E 66.55'
	L.C.R.C. Liber 6, Page 131 May 1991 F-1 Reset Cast Monument E 66.55' to Robinson corner SE 51.38' to Nail NW side 14" Pine SW 42.34' to Nail E side 10" Pine NW 69.37' to Nail W side 24" Pine	

10/19/98  
*DJK*

**B. Description of corner evidence found and/or method applied in restoring or reestablishing corner.**


F1-Found Cast Iron Monument in Box (0.04' North of Township line)  
Found Cast Iron Monument (F-1, T7N, R15W) N90°E 66.49'  
Found Nail in North side Twin Oak WSW 48.29'

This corner was not monumented by the original GLO survey. This monument is accepted as the best available evidence of the position of the corner.

**C. Description of monument for corner and accessories established to perpetuate locating the position of the corner.**

F-1 Cast Iron Monument 0.04' North of Township line in Monument Box  
Set Remon Tag & Nail WSW Side 26" Pine N08°W 69.27'  
Set Remon Tag & Nail SE Side 16" Pine N25°E 93.26'  
Set Remon Tag & Nail SE Side 8" Oak S40°W 37.74'  
Set Remon Tag & Nail SW Side 12" Pine S30°E 51.81'  
Cast Iron Monument in Monument Box (F-13, T7N, R15W) N90°E 66.49'  
In Centerline of East-West Road

\$11.00 CORNER  
Receipt #18213  
\$2.00 PHOTO  
Receipt #18213

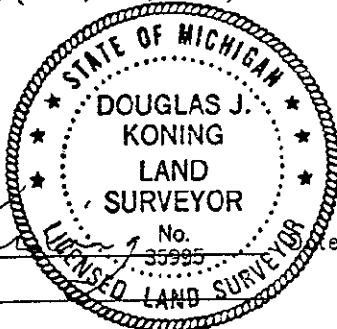

(see sketch on back)

Signed by Douglas J. Koning  
Surveyor's Michigan License No. 35995

LIBER 004 PAGE 232

SURVEY &  
REMONUMENTATION

JUN 28 1999

SECTION

NO SCALE

