

SURVEY & REMONUMENTATION

FEB 27 1998

SECTION

**OTTAWA COUNTY REMONUMENTATION
LAND CORNER RECORDATION CERTIFICATE**

RECORDED

97 DEC -8 AM 11:30

For corners in

Filing Requirement of Act 74, Mich. P.A. 1970

<u>Ottawa</u> (County)	Located in:	Corner Code #
1. Public Land Survey	T <u>6N</u> R <u>15W</u>	<u>F-9</u>
	T _____ R _____	(S 1/4 cor., Sec. 21
	T _____ R _____	Olive Twp.)
	T _____ R _____	_____
2. Property Controlling in Section	S _____ T _____ R _____	_____
	S _____ T _____ R _____	_____
3. Miscellaneous Property in Sec.	S _____ T _____ R _____	_____
	S _____ T _____ R _____	_____
4. Lot No. _____, Recorded Plat _____		
5. Private Claims _____		

Sam Schilt
REGISTER OF DEEDS
OTTAWA COUNTY, MI

Register of Deeds Stamp & File Number

A	B	C	D	E	F	G	H	I	J	K	L
2	6	5	4	3	2	1					
3											
4	7	8	9	10	11	12					
5											
6	18	17	16	15	14	13					
7											
8	19	20	21	22	23	24					
9											
10	30	29	28	27	26	25					
11											
12	31	32	33	34	35	36					
13											

I, Douglas J. Koning, in a field survey on 11-12, 1997, do hereby certify that under requirements of P.A. 74, Michigan P.A. of 1970, the corner points mentioned in lines 1 and 2 above were in conformance with regulations and rules therefore as required in the current manual of survey instructions of the United States Department of the Interior, Bureau of Land Management or by a decree of a Court of Law and/or that the corner points mentioned in lines 3, 4 and 5 above were in conformance with the rules of the Michigan Board of Land Surveyors or by a Decree of a Court of Law; established, re-established, monumented, re-monumented, recovered, found as expressed below:

NOTE: Not more than 4 corners, all in the same town and range, may be recorded on this certificate.

A. Description of original monument and accessories and/or subsequent restoration:

- F-9 Government Notes L.C.R.C. Liber 4, Page 151 February 1981
- Set Post May 1832 F-9 "T" Iron in Monument Box
- By Calvin Britain D.S. Telephone Pole SW 45.40'
- Sugar 18" N74E 20 Links Centerline Street Sign SE 42.79'
- Ironwood 6" S61W 41 Links Nail in West Face of the Most Westerly of two Power Poles SE 226.61'
- Power Pole NE 81.24'
- L.C.R.C. Liber 5, Page 97 December 1983
- F-9 Set Cast Iron Monument
- PK in Telephone Pole SW 45.41'
- Top & Center of Telephone Pole NW 54.92'
- PK in Power Pole NE 81.92'
- Centerline of Street sign SE 42.80'

B. Description of corner evidence found and/or method applied in restoring or reestablishing corner.

- F-9 Found Cast Iron Monument (Top broken) in Monument Box (in Centerline "x" ±)
- Found P.K. in SE Side Power Pole NE 81.27'
- Found Nail in Bottle Cap in Face of Power Pole NE 80.94'
- Found Centerline Street Sign SE 45.25'
- Found Stub of Power Pole no Nail SW 45.35'
- Found Small Nail in SW side Westerly most Power Pole of two SE 226.61'

P.A. 345 OTTAWA COUNTY

PEER APPROVED 11-17-97


G. D. K.

This marker is accepted as a careful and faithful perpetuation of the position of the original corner.

C. Description of monument for corner and accessories established to perpetuate locating the position of the corner.

- F-9 Cast Iron Monument (Top Broken) in Box in Centerline "x" ±
- Set Remon Nail & Tag in SE Side Power Pole N43E 81.29'
- Set Remon Nail & Tag in SW Side Westerly most Power Pole of 2 S55E 226.56'
- Set Remon Nail & Tag in SE Side Power Pole Stub S42W 45.42'
- Set Remon Nail & Tag in SW Side Westerly most Power Pole of 2 N40W 311.56'

\$ 9.00 CORNER
\$ 1.00 PHOTO

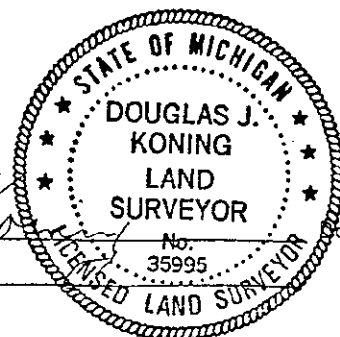

Signed by Douglas J. Koning Date 11-17-97
Surveyor's Michigan License No. 35995