

SURVEY & REMONUMENTATION

APR 05 1996

COMMISSION

**OTTAWA COUNTY REMONUMENTATION
LAND CORNER RECORDATION CERTIFICATE**

RECORDED

95 DEC 12 PM 4: 51

For corners in

Filing Requirement of Act 74, Mich. P.A. 1970

Phyllis Holman
REGISTER OF DEEDS
OTTAWA COUNTY, MI

<u>Ottawa</u> (County)	Located in:	Corner Code #
1. Public Land Survey	T <u>6N</u> R <u>15W</u>	F-11 (S 1/4 cor., Sec. 28 Olive Twp.)
	T _____ R _____	_____
	T _____ R _____	_____
	T _____ R _____	_____
2. Property Controlling in Section	S _____ T _____ R _____	_____
	S _____ T _____ R _____	_____
3. Miscellaneous Property in Sec.	S _____ T _____ R _____	_____
	S _____ T _____ R _____	_____
4. Lot No. _____, Recorded Plat _____		
5. Private Claims _____		

Register of Deeds Stamp & File Number

I, Douglas J. Koning, in a field survey on November 24, 1995, do hereby certify that under requirements of P.A. 74, Michigan P.A. of 1970, the corner points mentioned in lines 1 and 2 above were in conformance with regulations and rules therefore as required in the current manual of survey instructions of the United States Department of the Interior, Bureau of Land Management or by a decree of a Court of Law and/or that the corner points mentioned in lines 3,4 and 5 above were in conformance with the rules of the Michigan Board of Land Surveyors or by a Decree of a Court of Law; established, re-established, monumented, re-monumented, recovered, found as expressed below:

NOTE: Not more than 4 corners, all in the same town and range, may be recorded on this certificate.

	A	B	C	D	E	F	G	H	I	J	K	L	M
2	6	5	4	3	2	1							
3													
4	7	8	9	10	11	12							
5													
6	18	17	16	15	14	13							
7													
8	19	20	21	22	23	24							
9													
10	30	29	28	27	26	25							
11			▲										
12	31	32	33	34	35	36							
13													

A. Description of original monument and accessories and/of subsequent restoration:

F-11 Government Notes Set Post May 1832 Sugar 12" S31°E 20 Links Leo 10" N15°E 24 Links Calvin Britain D.S.	L.C.R.C. Liber 1, Page 269 February 1972 F-11 Set Steel Bar Nail in the face of Power Pole Nail in the face of Power Pole Nail in the face of Power pole NW Building corner	SE 58.85' SW 113.60' NE 175.50' SE 116.50'	L.C.R.C. Liber 3, Page 211 November 1972 F-11 Set Cast iron Monument Power Pole Centerline Street Sign Building Corner Power Pole	SE 59.50' SE 32.00' SE 116.80' NNE 175.95'
---	--	---	--	---

B. Description of corner evidence found and/or method applied in restoring or reestablishing corner.

F-11 Found Cast Iron Monument (1" below surface Gravel Road)
NW Corner Metal Building SE 116.34'


PA. 345 OTTAWA COUNTY
PEER APPROVED 12/11/95

Medoy D. Medewald
807

This marker is accepted as a careful and faithful perpetuation of the original corner.

C. Description of monument for corner and accessories established to perpetuate locating the position of the corner.

F-11 Cast Iron Monument (in Centerline "X" of Roads)		
Set Remon Tag & Nail in NE side Power Pole	S40°E	50.42'
Set Remon Tag & Nail in W side Power Pole	N20°E	163.49'
Set Remon Tag & Nail in W side Service Pole	S20°E	151.42'
Set Remon Tag & Nail in N side Power Pole	S80°W	267.58'

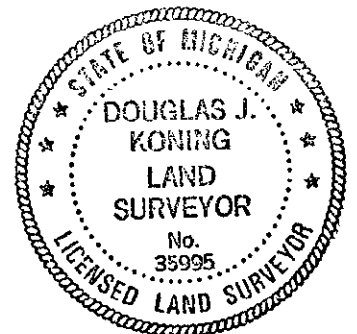

Signed by Douglas J. Koning
Surveyor's Michigan License No. 35995

Date 12-11-95