

**SURVEY &
REMONUMENTATION**

APR 05 1996

**COMMISSION OTTAWA COUNTY REMONUMENTATION
LAND CORNER RECORDATION CERTIFICATE**

RECORDED
95 DEC 12 PM 4: 51

Phyllis Kellerman
REGISTER OF DEEDS
OTTAWA COUNTY, MI

For corners in Ottawa (County) Located in: T 6N R 15W Corner Code # F-13
Filing Requirement of Act 74, Mich. P.A. 1970

1. Public Land Survey	T <u>6N</u> R <u>15W</u>	F-13
	T _____ R _____	(S 1/4 cor., Sec. 33
	T _____ R _____	Olive Twp.)
	T _____ R _____	_____
2. Property Controlling in Section	S _____ T _____ R _____	_____
	S _____ T _____ R _____	_____
3. Miscellaneous Property in Sec.	S _____ T _____ R _____	_____
	S _____ T _____ R _____	_____
4. Lot No. _____, Recorded Plat _____		
5. Private Claims _____		

Register of Deeds Stamp & File Number

A	B	C	D	E	F	G	H	I	J	K	L	M
2	6	5	4	3	2	1						
3												
4	7	8	9	10	11	12						
5												
6	18	17	16	15	14	13						
7												
8	19	20	21	22	23	24						
9												
10	30	29	28	27	26	25						
11												
12	31	32	33	34	35	36						
13												

I, Douglas J. Koning, in a field survey on November 21, 1995, do hereby certify that under requirements of P.A. 74, Michigan P.A. of 1970, the corner points mentioned in lines 1 and 2 above were in conformance with regulations and rules therefore as required in the current manual of survey instructions of the United States Department of the Interior, Bureau of Land Management or by a decree of a Court of Law and/or that the corner points mentioned in lines 3, 4 and 5 above were in conformance with the rules of the Michigan Board of Land Surveyors or by a Decree of a Court of Law; established, re-established, monumented, re-monumented, recovered, found as expressed below:

NOTE: Not more than 4 corners, all in the same town and range, may be recorded on this certificate.


- A. Description of original monument and accessories and/of subsequent restoration:
- F-13 Government Notes L.C.R.C. Liber 1, Page 269, February 1972
 - Set Post May 1832 F-13 Found "T" Iron
 - Beech 20" N44°W 36 Links Nail in Face of Power Pole SE 55.44'
 - Leo 4" N68°E 3 Links Found Iron NE 46.25'
 - Calvin Britain D.S. NW Edge Concrete Headwall ESE 49.96'
 - E Edge Concrete Headwall WNW 203.75'
 - L.C.R.C. Liber 3, Page 213, November 1977
 - F-13 Set Cast Iron Monument
 - Centerline Street Sign NE 45.86'
 - Power pole SE 55.9'
 - Holland corner E 69.74'

- B. Description of corner evidence found and/or method applied in restoring or reestablishing corner.
- F-13 Found Cast Iron Monument in Box
 - Found Nail SW side Power Pole SE 55.92'
 - Found Nail & Tag SW side Power Pole SE 55.59'
 - NW corner Concrete Headwall ESE 49.81'
 - E edge Concrete Headwall WNW 203.56'
 - Found Cast Iron Monument in box E 69.75'

PEER APPROVED 12/11/95
Wesley D. Newell
L.D.N.

This marker is accepted as a careful and faithful perpetuation of the original corner.

- C. Description of monument for corner and accessories established to perpetuate locating the position of the corner.
- F-13 Cast Iron Monument in Box (in Centerline "X" of Roads)
 - Set Remon Tag & Nail in SW side Power Pole S45°E 55.89'
 - Cut "X" in N end Concrete Headwall S55°E 50.04'
 - Found "X" in W end Concrete Headwall N85°E 96.60'
 - SW corner brick facing house #12375 New Holland N20°E 268.52'

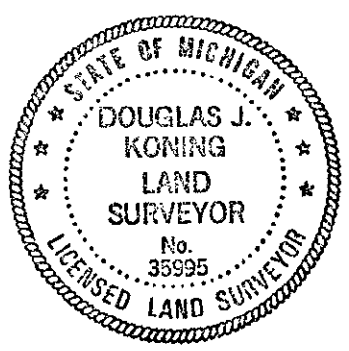

Signed by Douglas J. Koning Date 12-11-95
Surveyor's Michigan License No. 35995