

SURVEY & REMONUMENTATION

DEC 01 1993

COMMISSION

OTTAWA COUNTY REMONUMENTATION
LAND CORNER RECORDATION CERTIFICATE
 Filing Requirement of Act 74, Mich. P.A. 1970

RECORDED

93 NOV 11 AM 11:55

Dorothy A. Robinson
 REGISTER OF DEEDS
 OTTAWA COUNTY, MI


For corners in

Ottawa (County)	Located In:	Corner Code #
1. Public Land Survey	T <u>6N</u> R <u>15W</u>	<u>G-5</u> (NW corner of Sec. 15, Olive Twp.)
	T _____ R _____	_____
	T _____ R _____	_____
	T _____ R _____	_____
2. Property Controlling in Section	S _____ T _____ R _____	_____
	S _____ T _____ R _____	_____
3. Miscellaneous Property in Sec.	S _____ T _____ R _____	_____
	S _____ T _____ R _____	_____

Register of Deeds Stamp & File Number

4. Lot No. _____, Recorded Plat _____
 5. Private Claims _____

I, Douglas J. Koning in a field survey on September 8, 19 93, do hereby certify that under requirements of P.A. 74, Michigan P.A. of 1970, the corner points mentioned in lines 1 and 2 above were in conformance with regulations and rules therefore as required in the current manual of survey instructions of the United States Department of the Interior, Bureau of Land Management or by a decree of a Court of Law and/or that the corner points mentioned in lines 3, 4 and 5 above were in conformance with the rules of the Michigan Board of Land Surveyors or by a Decree of a Court of Law; established, re-established, monumented, re-monumented, recovered, found as expressed below:

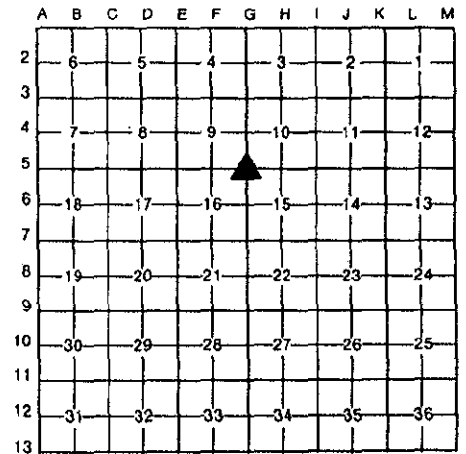

NOTE: Not more than 4 corners, all in the same town and range, may be recorded on this certificate.

A. Description of original monument and accessories and/or subsequent restoration:

L.C.R.C. L. 2 P. 155 1973	L.C.R.C. L. 2 P. 709 1974	L.C.R.C. L. 6 P. 55 1990
G-5 Found Iron Pipe in Mon. Box	G-5 Found 1" pinched pipe in Mon. Box	G-5
T. Pole NW 43.69'	28" Maple SE 91.10'	Set CIM
Face of Conc. Post NE 42.14'	Conc. cor. post N40°E 42.60'	Nail in Lgt. Pole NW 43.22'
Power Pole SE 86.55'	Tele Pole N40°W 44.22'	Nail in 4"X4" Post SW 50.14'
	St. sign post N43°E 42.50'	Nail in PP SW 88.36'
	P. Pole in center S35°E 88.58'	
	line blacktop N & S	

B. Description of corner evidence found and/or method applied in restoring or reestablishing corner:

G-5 Found C.I.M. in Mon. Box	
Nail in NE side T. Pole	NW 43.20'
Face of Conc. Post (Leaning)	NE 43.6'
Nail in NE side P. Pole	SE 88.37'
St. Sign Post	NE 42.8'
Nail in 4" X 4" Post	SW 50.14'

This marker is accepted as a careful and faithful perpetuation of the original corner.

C. Description of monument for corner and accessories established to perpetuate locating the position of the corner:

G-5 C.I.M. in Mon. Box (centerline of N, S, W Roads)	
Set Nail & O.C. Remon Tag in SW side light pole	N40°W 43.28'
Set Nail & O.C. Remon Tag in SW side power pole	S40°E 88.33'
Set Nail & O.C. Remon Tag in NW side power pole	S70°W 169.47'
NW cor. concrete block building foundation	S65°E 118.82'

Signed by Douglas J. Koning Date 10-19-93
 Surveyor's Michigan License No. 35995

