

**SURVEY &
REMONUMENTATION**

DEC 01 1993

COMMISSION

For corners in

OTTAWA COUNTY REMONUMENTATION
LAND CORNER RECORDATION CERTIFICATE
Filing Requirement of Act 74, Mich. P.A. 1970

RECORDED

93 NOV 11 AM 11:55


D. J. Koning
REGISTER OF DEEDS
OTTAWA COUNTY, MI

Ottawa <small>(County)</small>	Located In:	Corner Code #
1. Public Land Survey	T <u>6N</u> R <u>15W</u>	<u>G-7</u>
	T _____ R _____	(SW cor. Sec.
	T _____ R _____	<u>15, Olive Twp)</u>
	T _____ R _____	_____
2. Property Controlling in Section	S _____ T _____ R _____	_____
	S _____ T _____ R _____	_____
3. Miscellaneous Property in Sec.	S _____ T _____ R _____	_____
	S _____ T _____ R _____	_____

Register of Deeds Stamp & File Number

4. Lot No. _____, Recorded Plat _____
5. Private Claims _____

I, Douglas J. Koning, in a field survey on September 8, 19 93, do hereby certify that under requirements of P.A. 74, Michigan P.A. of 1970, the corner points mentioned in lines 1 and 2 above were in conformance with regulations and rules therefore as required in the current manual of survey instructions of the United States Department of the Interior, Bureau of Land Management or by a decree of a Court of Law and/or that the corner points mentioned in lines 3, 4 and 5 above were in conformance with the rules of the Michigan Board of Land Surveyors or by a Decree of a Court of Law; established, re-established, monumented, re-monumented, recovered, found as expressed below:

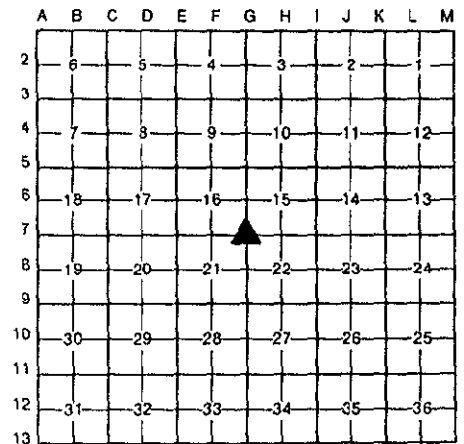

NOTE: Not more than 4 corners, all in the same town and range, may be recorded on this certificate.

A. Description of original monument and accessories and/or subsequent restoration:

L.C.R.C. L. 2 P. 155 1973	L.C.R.C. L. 2 P. 709 1974	L.C.R.C. L. 6 P. 55 1990
G-7 Found 1/2" Pipe in Mon. Box	G-7 P. Pole N55°E 59.88'	G-7
T. Pole NW 47.90'	Tele. Pole N45°W 47.87'	Set CIM
P. Pole NE 59.75'	St. Sign post S55°W 35.95'	Nail in Lgt. Pole NW 47.15'
St. Sign SW 35.95'		Nail in PP NE 60.16'
		Nail in 4"X4" Post SE 55.12'
		Nail in 4"X4" Post SW 42.60'

B. Description of corner evidence found and/or method applied in restoring or reestablishing corner:

G-7 C.I.M. in Mon. Box (Centerline of crossing of roads)
PK Nail SE Side TP NW 48.02'
Nail & Tag SW Side PP NE 59.75'

This marker is accepted as a careful and faithful perpetuation of the original corner.

C. Description of monument for corner and accessories established to perpetuate locating the position of the corner:

G-7 C.I. Mon. in Box (Centerline of crossing of roads)
Nail and O.C. Remon Tag S. Side Power Pole N64°E 60.05'
Nail and O.C. Remon Tag NW side Power Pole S15°E 201.45'
Nail and O.C. Remon Tag SW side Light Pole N40°W 47.61'
Nail and O.C. Remon Tag S. side Triple Basswood N84°W 300.33'

Signed by Douglas J. Koning Date 10-19-93
Surveyor's Michigan License No. 35995

