

**SURVEY &
REMONUMENTATION**

DEC 01 1993

COMMISSION

For corners in

OTTAWA COUNTY REMONUMENTATION
LAND CORNER RECORDATION CERTIFICATE
Filing Requirement of Act 74, Mich. P.A. 1970

RECORDED

93 NOV 11 AM 11:55

Phyllis Robinson
REGISTER OF DEEDS
OTTAWA COUNTY, MI

| Ottawa (County) | Located In: | Corner Code # |
|---------------------------------------|--------------------------|----------------|
| 1. Public Land Survey | T <u>6N</u> R <u>15W</u> | G-8 |
| | T ___ R ___ | (W 1/4 cor |
| | T ___ R ___ | Sec. 22, Olive |
| | T ___ R ___ | Twp.) |
| 2. Property Controlling in Section | S ___ T ___ R ___ | ___ |
| | S ___ T ___ R ___ | ___ |
| 3. Miscellaneous Property in Sec. | S ___ T ___ R ___ | ___ |
| | S ___ T ___ R ___ | ___ |

Register of Deeds Stamp & File Number

4. Lot No. _____, Recorded Plat _____
5. Private Claims _____

| | A | B | C | D | E | F | G | H | I | J | K | L | M |
|----|----|----|----|----|----|----|---|---|---|---|---|---|---|
| 2 | 6 | 5 | 4 | 3 | 2 | 1 | | | | | | | |
| 3 | | | | | | | | | | | | | |
| 4 | 7 | 8 | 9 | 10 | 11 | 12 | | | | | | | |
| 5 | | | | | | | | | | | | | |
| 6 | 18 | 17 | 16 | 15 | 14 | 13 | | | | | | | |
| 7 | | | | | | | | | | | | | |
| 8 | 19 | 20 | 21 | 22 | 23 | 24 | | | | | | | |
| 9 | | | | | | | | | | | | | |
| 10 | 30 | 29 | 28 | 27 | 26 | 25 | | | | | | | |
| 11 | | | | | | | | | | | | | |
| 12 | 31 | 32 | 33 | 34 | 35 | 36 | | | | | | | |
| 13 | | | | | | | | | | | | | |

I, Douglas J. Koning, in a field survey on September 9, 19 93, do hereby certify that under requirements of P.A. 74, Michigan P.A. of 1970, the corner points mentioned in lines 1 and 2 above were in conformance with regulations and rules therefore as required in the current manual of survey instructions of the United States Department of the Interior, Bureau of Land Management or by a decree of a Court of Law and/or that the corner points mentioned in lines 3, 4 and 5 above were in conformance with the rules of the Michigan Board of Land Surveyors or by a Decree of a Court of Law, established, re-established, monumented, re-monumented, recovered, found as expressed below:

NOTE: Not more than 4 corners, all in the same town and range, may be recorded on this certificate.

A. Description of original monument and accessories and/or subsequent restoration:

| | |
|---------------------------|--|
| L.C.R.C. L. 2 P. 289 1973 | L.C.R.C. L. 6 P. 54 1990 |
| G-8 Found Mon. Box | Set C.I.M. |
| | Top NE cor. of Steel Flag Pole Base SW 102.15' |
| | PK Nail in PP WNW 139.67' |
| | PK Nail in PP NE 75.20' |

B. Description of corner evidence found and/or method applied in restoring or reestablishing corner:

G-8 Found C.I.M. in Mon. Box
Top NE cor. of Steel Flag Pole Base SW 102.15'
PK Nail in PP WNW 139.67'
PK Nail in PP NE 75.20'


This marker is accepted as a careful and faithful perpetuation of the original corner.

C. Description of monument for corner and accessories established to perpetuate locating the position of the corner:

| | | |
|--|-------|---------|
| G-8 C.I. Mon. in Box (Centerline of crossing of roads) | | |
| Nail and O.C. Remon Tag in N'y side of Power Pole | N65°W | 139.64' |
| Nail and O.C. Remon Tag in SE side of Power Pole | N43°E | 75.16' |
| Nail and O.C. Remon Tag in SW side of 6" Elm | S45°E | 50.82' |

Signed by Douglas J. Koning Date 10-19-93

Surveyor's Michigan License No. 35995

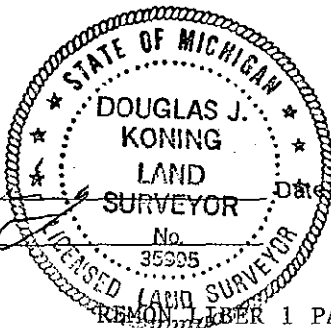

FORM APPROVED BY MICHIGAN STATE BOARD OF LAND SURVEYORS, JAN. 28, 1971
REVISED MAY 14, 1975
REVISED JAN., 1983