

**SURVEY & REMONUMENTATION**

OCT 07 1996

COMMISSION

OTTAWA COUNTY REMONUMENTATION  
LAND CORNER RECORDATION CERTIFICATE

RECORDED

96 AUG 26 PM 2:01

For corners in

Filing Requirement of Act 74, Mich. P.A. 1970

Ottawa (County)	Located in:	Corner Code #
1. Public Land Survey	T 6N R15W T _____ R _____ T _____ R _____ T _____ R _____	G-10 (E 1/4 cor., Sec. 28 Olive Twp.)
2. Property Controlling in Section	S _____ T _____ R _____ S _____ T _____ R _____	_____
3. Miscellaneous Property in Sec.	S _____ T _____ R _____ S _____ T _____ R _____	_____
4. Lot No. _____, Recorded Plat _____		
5. Private Claims _____		

*D. J. Koning*  
REGISTER OF DEEDS  
OTTAWA COUNTY, MI

Register of Deeds Stamp & File Number

A	B	C	D	E	F	G	H	I	J	K	L	M
2	6	5	4	3	2	1						
3												
4	7	8	9	10	11	12						
5												
6	18	17	16	15	14	13						
7												
8	19	20	21	22	23	24						
9												
10	30	29	28	27	26	25						
11												
12	31	32	33	34	35	36						
13												

Douglas J. Koning, in a field survey on July 18, 1996, do hereby certify that under requirements of P.A. 74, Michigan P.A. of 1970, the corner points mentioned in lines 1 and 2 above were in conformance with regulations and rules therefore as required in the current manual of survey instructions of the United States Department of the Interior, Bureau of Land Management or by a decree of a Court of Law and/or that the corner points mentioned in lines 3, 4 and 5 above were in conformance with the rules of the Michigan Board of Land Surveyors or by a Decree of a Court of Law; established, re-established, monumented, re-monumented, recovered, found as expressed below:

NOTE: Not more than 4 corners, all in the same town and range, may be recorded on this certificate.

A. Description of original monument and accessories and/or subsequent restoration:

G-10 Government Notes Set Post May 1832 By Calvin Britain D.S. Beech 10" N79°E 13 Links Leo 7" S56°W 34 Links	L.C.R.C. Liber 1, Page 281 February 1972 G-10 Found 1/2" Steel Bar Nail in the face of Power Pole Nail in the face of Power Pole U.S.G.S. Benchmark	SW 43.97' SE 59.87' SW 41.80'	L.C.R.C. Liber 4, Page 122 November 1980 G-10 Set Cast Iron Monument 33" Cherry 21" Red Oak 19" Black Oak Fence 15" Oak	S 4.67' SE 27.92' SW 45.84' W 0.4' NE 29.38'
---	---	-------------------------------------	---	--

B. Description of corner evidence found and/or method applied in restoring or reestablishing corner.

G-10 Found 5/8" Steel bar in box Found Nail & Tag (#14091) in NE face Guy Pole USGS Benchmark Found Nail & Tag (#14091) in NW face Power Pole	SW 43.99' SW 41.83' SE 59.93'
--	-------------------------------------

P.A. 345 OTTAWA COUNTY

PEER APPROVED 8-20-96


*Douglas J. Koning*

NOTE: L.C.R.C. Liber 4, Page 122 Witness could not be for corner G-10 T6N, R15W

This marker is accepted as a careful and faithful perpetuation of the original corner.

C. Description of monument for corner and accessories established to perpetuate locating the position of the corner.

G-10 Set 3/4" Form pin and Remon cap Set Remon Tag & Nail in NEly side Power Pole Set Remon Tag & Nail in Sly side Power Pole Set Remon Tag & Nail in NWly side Guy Pole Set Remon Tag & Nail in SWly side Power Pole Set Remon Tag & Nail in Ely side Power Pole In centerline "X" of roads	S40°E 60.39' S65°E 196.64' S50°W 44.32' N35°W 260.01' N20°E 140.30'
--	---

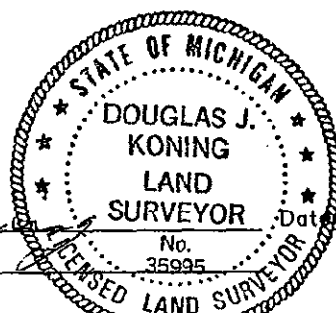

Signed by Douglas J. Koning  
Surveyor's Michigan License No. 35995

Date 8-20-96