

**SURVEY &  
MONUMENTATION**

OCT 07 1996

**COMMISSION**

**OTTAWA COUNTY REMONUMENTATION  
LAND CORNER RECORDATION CERTIFICATE**

For corners in

Filing Requirement of Act 74, Mich. P.A. 1970 **RECORDED**

<u>Ottawa</u> (County)	Located in:	Corner Code #
1. Public Land Survey	T 6N R15W	G-11
	T _____ R _____	SE (SW cor., Sec. 28
	T _____ R _____	Olive Twp.)
	T _____ R _____	
2. Property Controlling in Section	S _____ T _____ R _____	
	S _____ T _____ R _____	
3. Miscellaneous Property in Sec.	S _____ T _____ R _____	
	S _____ T _____ R _____	
4. Lot No. _____, Recorded Plat _____		
5. Private Claims _____		

96 AUG 26 PM 2:01

*Dorothy Redmond*  
REGISTER OF DEEDS  
OTTAWA COUNTY, MI

Register of Deeds Stamp & File Number

A	B	C	D	E	F	G	H	I	J	K	L	M
2	6	5	4	3	2	1						
3												
4	7	8	9	10	11	12						
5												
6	18	17	16	15	14	13						
7												
8	19	20	21	22	23	24						
9												
10	30	29	28	27	26	25						
11												
12	31	32	33	34	35	36						
13												

Douglas J. Koning, in a field survey on July 18, 1996, do hereby certify that under requirements of P.A. 74, Michigan P.A. of 1970, the corner points mentioned in lines 1 and 2 above were in conformance with regulations and rules therefore as required in the current manual of survey instructions of the United States Department of the Interior, Bureau of Land Management or by a decree of a Court of Law and/or that the corner points mentioned in lines 3, 4 and 5 above were in conformance with the rules of the Michigan Board of Land Surveyors or by a Decree of a Court of Law; established, re-established, monumented, re-monumented, recovered, found as expressed below:

NOTE: Not more than 4 corners, all in the same town and range, may be recorded on this certificate.

**A. Description of original monument and accessories and/of subsequent restoration:**

G-11 Government Notes	L.C.R.C. Liber 2, Page 19 February 1973
Set Post May 1832	G-11 Found Steel Bar
By Calvin Britain D.S.	Power Pole SE 74.68'
Sugar 12" N87°E 27 Links	24" Basswood SE 65.54'
Beech 14" S48°W 23 Links	Power Pole NNE 116.47'
	Street Sign SE 42.57'

P.A. 345 OTTAWA COUNTY  
PEER APPROVED 8-20-96

*Dorothy Redmond*

**B. Description of corner evidence found and/or method applied in restoring or reestablishing corner.**


G-11 Found Steel Bar in Box  
Found Nail & Tag (#14091) in SE face Power Pole NNE 116.31'  
Found Street Sign Base SE 42.62'

This marker is accepted as a careful and faithful perpetuation of the original corner.

**C. Description of monument for corner and accessories established to perpetuate locating the position of the corner.**

G-11 Set 3/4" Form Pin & Remon Cap		
Set Remon Tag & Nail in SE side Power Pole	N34°E	116.78'
Set Remon Tag & Nail in N side Power Pole	S87°W	240.54'
Set Remon Tag & Nail in N side Power Pole	S55°E	70.05'
Set Remon Tag & Nail in E side 20" Basswood	S15°E	98.76'

Signed by Douglas J. Koning  
Surveyor's Michigan License No. 35995

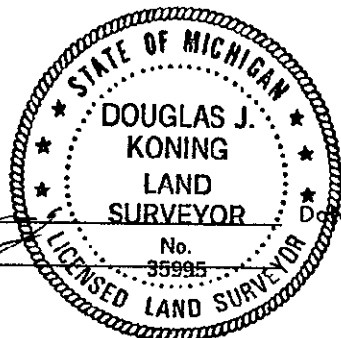

Date 8-20-96