

**SURVEY &
REMONUMENTATION**

DEC 01 1993

COMMISSION

**OTTAWA COUNTY REMONUMENTATION
LAND CORNER RECORDATION CERTIFICATE
Filing Requirement of Act 74, Mich. P.A. 1970**

RECORDED

93 NOV 11 AM 11:55

D. J. Koning
REGISTER OF DEEDS
OTTAWA COUNTY, MI

For corners in

<u>Ottawa</u> (County)	Located In:	Corner Code #
1. Public Land Survey	T <u>6N</u> R <u>15W</u>	<u>H-7</u>
	T _____ R _____	(S 1/4 cor. _____)
	T _____ R _____	<u>Sec. 15, Olive</u>
	T _____ R _____	<u>Twp.)</u>
2. Property Controlling in Section	S _____ T _____ R _____	_____
	S _____ T _____ R _____	_____
3. Miscellaneous Property in Sec.	S _____ T _____ R _____	_____
	S _____ T _____ R _____	_____
4. Lot No. _____, Recorded Plat _____		
5. Private Claims _____		

Register of Deeds Stamp & File Number

I, Douglas J. Koning, in a field survey on September 9, 19 93, do hereby certify that under requirements of P.A. 74, Michigan P.A. of 1970, the corner points mentioned in lines 1 and 2 above were in conformance with regulations and rules therefore as required in the current manual of survey instructions of the United States Department of the Interior, Bureau of Land Management or by a decree of a Court of Law and/or that the corner points mentioned in lines 3, 4 and 5 above were in conformance with the rules of the Michigan Board of Land Surveyors or by a Decree of a Court of Law; established, re-established, monumented, re-monumented, recovered, found as expressed below:

A	B	C	D	E	F	G	H	I	J	K	L	M
2	6	5	4	3	2	1						
3												
4	7	8	9	10	11	12						
5												
6	18	17	16	15	14	13						
7												
8	19	20	21	22	23	24						
9												
10	30	29	28	27	26	25						
11												
12	31	32	33	34	35	36						
13												

NOTE: Not more than 4 corners, all in the same town and range, may be recorded on this certificate.

A. Description of original monument and accessories and/or subsequent restoration:

L.C.R.C. L. 2 P. 155 1973
H-7 Set Cast Iron Mon. on line and 1/2 way
Cut "X" in Culvert NW 27.22'
P. Pole NE 37.20'
P. Pole SSE 37.22'

B. Description of corner evidence found and/or method applied in restoring or reestablishing corner:

H-7 Found C.I. Mon. in centerline of Gravel Road at Road Surface (top busted off)
"X" in Culvert NW 27.16'
Nail & Tag W. Side Power Pole NE 37.20'
Nail & Tag W. Side Power Pole SSE 37.64'

This marker is accepted as a careful and faithful perpetuation of the original corner.


C. Description of monument for corner and accessories established to perpetuate locating the position of the corner:

H-7 Cast Iron Mon. in centerline of Gravel Road at Road Surface (top busted off)
Set Nail and O.C. Remon Tag in E. Side P. Pole S13°E 37.72'
NE Corner Concrete Block House #11612 S12°W 108.01'
NW Corner Concrete Block House #11612 S31°W 121.75'
"X" out top centerline of 12" Conc. Culvert N32°W 27.16'
Set Nail and O.C. Remon Tag in SE side Power Pole N40°E 37.63'

Signed by

Douglas J. Koning

Surveyor's Michigan License No. 35995

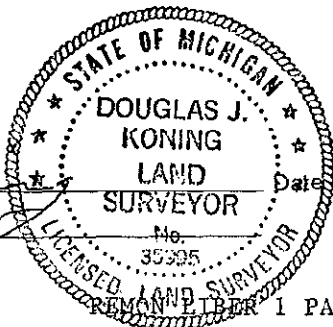

Date

10-19-93

FORM APPROVED BY MICHIGAN STATE BOARD OF LAND SURVEYORS, JAN. 28, 1971
REVISED MAY 14, 1975
REVISED JAN., 1983