

SURVEY & RE-MONUMENTATION

APR 05 1996

RECORDED

COMMISSION

OTTAWA COUNTY REMONUMENTATION

95 DEC 12 PM 4:51

LAND CORNER RECORDATION CERTIFICATE

Filing Requirement of Act 74, Mich. P.A. 1970

Douglas J. Koning
REGISTER OF DEEDS
OTTAWA COUNTY, MI

For corners in

Ottawa (County)	Located in:	Corner Code #
1. Public Land Survey	T 6N R 15W T _____ R _____ T _____ R _____ T _____ R _____	H-11 (S 1/4 cor., Sec. 27 Olive Twp.)
2. Property Controlling in Section	S _____ T _____ R _____ S _____ T _____ R _____	_____
3. Miscellaneous Property In Sec.	S _____ T _____ R _____ S _____ T _____ R _____	_____
4. Lot No. _____, Recorded Plat _____		
5. Private Claims _____		

Register of Deeds Stamp & File Number

	A	B	C	D	E	F	G	H	I	J	K	L	M
2	6	5	4	3	2								
3													
4	7	8	9	10	11	12							
5													
6	18	17	16	15	14	13							
7													
8	19	20	21	22	23	24							
9													
10	30	29	28	27	26	25							
11													
12	31	32	33	34	35	36							
13													

I, Douglas J. Koning, in a field survey on November 24, 1995, do hereby certify that under requirements of P.A. 74, Michigan P.A. of 1970, the corner points mentioned in lines 1 and 2 above were in conformance with regulations and rules therefore as required in the current manual of survey instructions of the United States Department of the Interior, Bureau of Land Management or by a decree of a Court of Law and/or that the corner points mentioned in lines 3, 4 and 5 above were in conformance with the rules of the Michigan Board of Land Surveyors or by a Decree of a Court of Law; established, re-established, monumented, re-monumented, recovered, found as expressed below:

NOTE: Not more than 4 corners, all in the same town and range, may be recorded on this certificate.

A. Description of original monument and accessories and/of subsequent restoration:

H-11 Government Notes	L.C.R.C. Liber 3, Page 211 November 1977
Set Post May 1832	H-11 Set Cast Iron Monument
Maple 10" N85°E 6 Links	Power Pole NW 129.05'
Leo 10" N77°W 34 Links	Centerline Street Sign SE 34.95'
Calvin Britain D.S.	Power Pole SE 119.95'

PA. 345 OTTAWA COUNTY
PEER APPROVED 12/11/95

Medoy D. Medewald
M.D.


B. Description of corner evidence found and/or method applied in restoring or reestablishing corner.

H-11 Found Cast Iron Monument
Found Nail W side Power Pole S30°E 119.27'
Found Nail NE side Power Pole N30°W 128.88'

This marker is accepted as a careful and faithful perpetuation of the original corner.

C. Description of monument for corner and accessories established to perpetuate locating the position of the corner.

H-11 Cast Iron Monument (4' N of Centerline "X" of Roads)
Set Remon Tag & Nail in W side Power Pole N30°W 128.76'
Set Remon Tag & Nail in N side Power Pole S85°W 182.59'
Set Remon Tag & Nail in S side Power Pole S75°E 124.36'
Set Remon Tag & Nail in W side Power Pole S30°E 119.90'
Set Remon Tag & Nail in S side Power Pole N70°E 81.75'

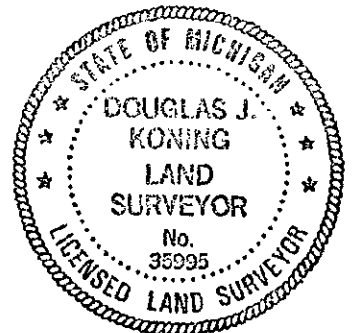

Signed by Douglas J. Koning
Surveyor's Michigan License No. 35995

Date 12-11-95