

SURVEY & REMONUMENTATION

FEB 27 1998

SECTION

RECORDED

97 OCT 30 AM 10:59

**OTTAWA COUNTY REMONUMENTATION
LAND CORNER RECORDATION CERTIFICATE**

For corners in Ottawa Located in: Olive Twp. Corner Code # 1-2
(County) Filing Requirement of Act 74, Mich. P.A. 1970

Debra Gant

Register of Deeds
Ottawa County, MI

1. Public Land Survey	T <u>6N</u> R <u>15W</u>	<u>1-2</u>
	T _____ R _____	(W 1/4 cor., Sec. 2
	T _____ R _____	Olive Twp.)
	T _____ R _____	
2. Property Controlling In Section	S _____ T _____ R _____	
	S _____ T _____ R _____	
3. Miscellaneous Property in Sec.	S _____ T _____ R _____	
	S _____ T _____ R _____	
4. Lot No. _____, Recorded Plat _____		
5. Private Claims _____		

Register of Deeds Stamp & File Number

	A	B	C	D	E	F	G	H	I	J	K	L	M
2	6	5	4	3	▲	2	1						
3													
4	7	8	9	10	11	12							
5													
6	18	17	16	15	14	13							
7													
8	19	20	21	22	23	24							
9													
10	30	29	28	27	26	25							
11													
12	31	32	33	34	35	36							
13													

I, Douglas J. Koning, in a field survey on September 3, 1997, do hereby certify that under requirements of P.A. 74, Michigan P.A. of 1970, the corner points mentioned in lines 1 and 2 above were in conformance with regulations and rules therefore as required in the current manual of survey instructions of the United States Department of the Interior, Bureau of Land Management or by a decree of a Court of Law and/or that the corner points mentioned in lines 3, 4 and 5 above were in conformance with the rules of the Michigan Board of Land Surveyors or by a Decree of a Court of Law; established, re-established, monumented, re-monumented, recovered, found as expressed below:

NOTE: Not more than 4 corners, all in the same town and range, may be recorded on this certificate.

A. Description of original monument and accessories and/or subsequent restoration:

B-1 Government Notes Set Post May 1832 By Calvin Britain D.S. Hemlock 6" is Post	L.C.R.C. Liber 1, Page 143, November 1971 1-2 Found Iron Pipe Nail in face of Telephone Pole NE 58.38' Nail in face of Street Sign SE 38.70' Nail in face of 36" Maple NW 97.60'	L.C.R.C. Liber 1, Page 819, December 1972 1-2 3/4" Iron in Mon Box SW corner headwall S55°W 27.9' NW corner Bldg fnd S45°E 68.6' SE corner headwall N17°E 41.6' 36" Maple N27°W 97.6' Centerline Pavement N 6'
	L.C.R.C. Liber 5, Page 87, December 1983 1-2 Set Cast Iron Monument 10" Maple SSW 88.54' 28" Maple NW 98.45' Tel. Pole NE 52.54' Tel. Pole SE 45.01'	

B. Description of corner evidence found and/or method applied in restoring or reestablishing corner.

1-2 Found Cast Iron Mon in Mon box 6'± South of centerline
Found Nail in N'ly side Power Pole S68°E 86.71'
NW corner Building Foundation (concrete) S45°E 68.59'
SW corner Conc. headwall (broken) S55°W 27.9'±
Found Nail in W side 12" Triple Maple S15°W 88.37'


P.A. 345 OTTAWA COUNTY
PEER APPROVED 10/27/97
[Signature]

This marker is accepted as a careful and faithful perpetuation of the original corner.

C. Description of monument for corner and accessories established to perpetuate locating the position of the corner.

1-2 Cast Iron Mon in Mon box	S68°E 86.71'
Set Ottawa County Remon Nail & Tag in N'ly side Power Pole	N22°W 98.57'
Set Ottawa County Remon Nail & Tag in W'ly side 36" Maple	S15°W 88.35'
Set Ottawa County Remon Nail & Tag in W'ly side 12" Triple Maple	N74°W 173.55'
Set Ottawa County Remon Nail & Tag in W'ly side Power Pole	S45°E 68.59'
NW corner Building Foundation (concrete)	North 6'
Centerline East-West road	

\$ 9.00 CORNER
\$ 1.00 PHOTO

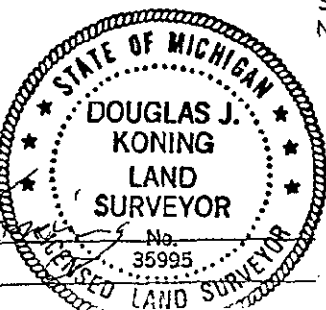

Signed by Douglas J. Koning
Surveyor's Michigan License No. 35995
REMON LIBER 3 PAGE 529

Date 10-27-97