

SURVEY & REMONUMENTATION

FEB 27 1998

SECTION

Ottawa County Remonumentation

LAND CORNER RECORDATION CERTIFICATE

RECORDED

For corners in

Filing Requirement of Act 74, Mich. P.A. 1970

97 DEC -8 AM 11:31

Ottawa (County)	Located in:	Corner Code #
1. Public Land Survey	T 6N R 15W	1-3
	T _____ R _____	(NW cor., Sec. 11
	T _____ R _____	Olive Twp.)
	T _____ R _____	_____
	T _____ R _____	_____
2. Property Controlling in Section	S _____ T _____ R _____	_____
	S _____ T _____ R _____	_____
3. Miscellaneous Property in Sec.	S _____ T _____ R _____	_____
	S _____ T _____ R _____	_____
4. Lot No. _____, Recorded Plat _____		
5. Private Claims _____		

Ray Schultz
REGISTER OF DEEDS
OTTAWA COUNTY, MI

Register of Deeds Stamp & File Number

A	B	C	D	E	F	G	H	I	J	K	L	M
2	6	5	4	3	2	1						
3												
4	7	8	9	10	11	12						
5												
6	18	17	16	15	14	13						
7												
8	19	20	21	22	23	24						
9												
10	30	29	28	27	26	25						
11												
12	31	32	33	34	35	36						
13												

I, Douglas J. Koning, in a field survey on November 26, 1997, do hereby certify that under requirements of P.A. 74, Michigan P.A. of 1970, the corner points mentioned in lines 1 and 2 above were in conformance with regulations and rules therefore as required in the current manual of survey instructions of the United States Department of the Interior, Bureau of Land Management or by a decree of a Court of Law and/or that the corner points mentioned in lines 3, 4 and 5 above were in conformance with the rules of the Michigan Board of Land Surveyors or by a Decree of a Court of Law; established, re-established, monumented, re-monumented, recovered, found as expressed below:

NOTE: Not more than 4 corners, all in the same town and range, may be recorded on this certificate.

A. Description of original monument and accessories and/or subsequent restoration:

I-1 Government Notes Set Post May 1832 By Calvin Britain D.S. Beech 10" N69°E 4 Links Leo 11" N48°W 9 Links	L.C.R.C. Liber 1, Page 143, November 1971 I-3 Set Cast Iron Monument Nail in face of 6" Pine NW 88.26' Nail in face of 18" Cherry NW 106.02' Nail in face of Telephone Pole SW 47.75' Street Sign SE 26.81'	L.C.R.C. Liber 3, Page 154, January 1977 I-3 Set Cast Iron Monument SW Corner House foundation 108.80' MBT Pole SW 44.41' Centerline Street Sign SE 36.78'
L.C.R.C. Liber 2, Page 117, October 1976 I-3 Found O.C.R.C. Marker Found Nail & Tag #14091 in 12" triple W. Cherry WNW 106.00' SW corner House Foundation NE 106.53' Found Nail & Tag in Power Pole SW 48.02' Centerline 112th W 7.5± Centerline Taylor S 4±		

B. Description of corner evidence found and/or method applied in restoring or reestablishing corner.

I-3 Found Cast Iron Monument
Found Nail & Tag #14091 in face 14" Triple Cherry WNW 95.90'
SW Coarner House Foundation #8810 N42°E 108.71'
NW corner House (Corner of brick) #8790 S55°E 102.89'
NE corner House Foundation S44°W 141.61'

P.A. 345 OTTAWA COUNTY

PEER APPROVED 12-1-97

YDZ


C. Description of monument for corner and accessories established to perpetuate locating the position of the corner.

I-3 3/4" Iron in Monument Box
0.5± West of Centerline Bit. Road
6± North of Centerline E-W Gravel Road
Found Nail & Tag #14091 in face 14" Triple Cherry WNW 95.90'
SW Corner House Foundation #8810 N42°E 108.71'
NW corner House (Corner of brick) #8790 S55°E 102.89'
NE corner House Foundation S44°W 141.61'

\$ 9.00 CORNER
\$ 1.00 PHOTO

THIS MARKER IS BEING WITNESSED AS PART OF A ROAD RECONSTRUCTION PROJECT AND HAS NOT BEEN APPROVED BY THE OTTAWA COUNTY REMONUMENTATION PEER GROUP AT THIS TIME.

Signed by Douglas J. Koning
Surveyor's Michigan License No. 35995

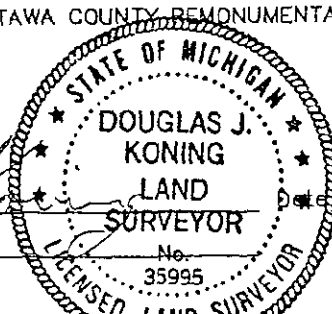

12-1-97