

SURVEY & REMONUMENTATION

DEC 01 1993

COMMISSION

OTTAWA COUNTY REMONUMENTATION
LAND CORNER RECORDATION CERTIFICATE
 Filing Requirement of Act 74, Mich. P.A. 1970

RECORDED

93 NOV 11 AM 11:55


D. J. Koning
 REGISTER OF DEEDS
 OTTAWA COUNTY, MI

For corners in

Ottawa (County)	Located In:	Corner Code #
1. Public Land Survey	T <u>6N</u> R <u>15W</u>	<u>I-5</u>
	T _____ R _____	<u>(NE cor. Sec.</u>
	T _____ R _____	<u>15, Olive Twp)</u>
	T _____ R _____	_____
2. Property Controlling in Section	S _____ T _____ R _____	_____
	S _____ T _____ R _____	_____
3. Miscellaneous Property in Sec.	S _____ T _____ R _____	_____
	S _____ T _____ R _____	_____
4. Lot No. _____, Recorded Plat _____		
5. Private Claims _____		

Register of Deeds Stamp & File Number

I, Douglas J. Koning in a field survey on September 9, 19 93 do hereby certify that under requirements of P.A. 74, Michigan P.A. of 1970, the corner points mentioned in lines 1 and 2 above were in conformance with regulations and rules therefore as required in the current manual of survey instructions of the United States Department of the Interior, Bureau of Land Management or by a decree of a Court of Law and/or that the corner points mentioned in lines 3, 4 and 5 above were in conformance with the rules of the Michigan Board of Land Surveyors or by a Decree of a Court of Law, established, re-established, monumented, re-monumented, recovered, found as expressed below:

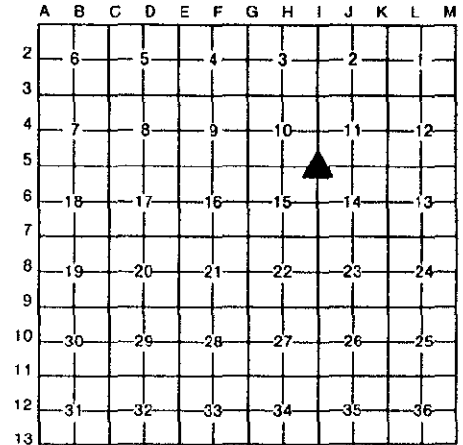

NOTE: Not more than 4 corners, all in the same town and range, may be recorded on this certificate.

A. Description of original monument and accessories and/or subsequent restoration:

L.C.R.C. L. 1 P. 425 1972	L.C.R.C. L. 2 P. 711 1974	L.C.R.C. L. 3 P. 354 1979
I-5 Found "I" Iron	I-5 St. Sign Post	I-5 Found Iron With Cap
St. Sign NE 37.98'	RR tie Fence Cor. N45°E 38.20'	N45°E Sign Post 38.20'
P.P. NE 65.43'	T. Pole N44°E 42.08'	N44°E Fence Cor. 42.08'
P.P. SW 90.90'	10" Pine S20°W 109.12'	N45°W T. Pole 43.90'
		S20°W 10" Pine 109.12'

B. Description of corner evidence found and/or method applied in restoring or reestablishing corner:

I-5 Found C.I. Mon. in Mon. Box
 Nail and Tag West Side RR Tie Fence Corner NE 42.95'
 PK Southerly Side PP SW 90.98'

This marker is accepted as a careful and faithful perpetuation of the original corner.

C. Description of monument for corner and accessories established to perpetuate locating the position of the corner:

I-5 C.I. Mon in Box (Centerline of crossing of N, S, E, and W Roads)
 Nail and O.C. Remon. Tag NE Side 20" Basswood N60°W 86.46'
 Nail and O.C. Remon. Tag SE side Power Pole N40°E 66.11
 Nail and O.C. Remon. Tag SW side of Triple Ash 10" S45°E 73.60'
 Nail and O.C. Remon. Tag SE side of Power Pole S60°W 90.96'

Signed by Douglas J. Koning Date 10-19-93
 Surveyor's Michigan License No. 35995

