

SURVEY & REMONUMENTATION

DEC 01 1993

COMMISSION

**OTTAWA COUNTY REMONUMENTATION
LAND CORNER RECORDATION CERTIFICATE**
Filing Requirement of Act 74, Mich. P.A. 1970

RECORDED

93 NOV 11 AM 11:55

Richard A. ...
REGISTER OF DEEDS
OTTAWA COUNTY, MI

Sequence #1


For corners in

Ottawa (County)	Located In:	Corner Code #
1. Public Land Survey	T 6N R 15W	I-6 (E 1/4 cor. Sec. 15, Olive Twp.)
	T _____ R _____	_____
	T _____ R _____	_____
	T _____ R _____	_____
2. Property Controlling in Section	S _____ T _____ R _____	_____
	S _____ T _____ R _____	_____
3. Miscellaneous Property in Sec.	S _____ T _____ R _____	_____
	S _____ T _____ R _____	_____
4. Lot No. _____, Recorded Plat _____		
5. Private Claims _____		

Register of Deeds Stamp & File Number

I, Douglas J. Koning in a field survey on September 9, 1993, do hereby certify that under requirements of P.A. 74, Michigan P.A. of 1970, the corner points mentioned in lines 1 and 2 above were in conformance with regulations and rules therefore as required in the current manual of survey instructions of the United States Department of the Interior, Bureau of Land Management or by a decree of a Court of Law and/or that the corner points mentioned in lines 3, 4 and 5 above were in conformance with the rules of the Michigan Board of Land Surveyors or by a Decree of a Court of Law; established, re-established, monumented, re-monumented, recovered, found as expressed below:

NOTE: Not more than 4 corners, all in the same town and range, may be recorded on this certificate.

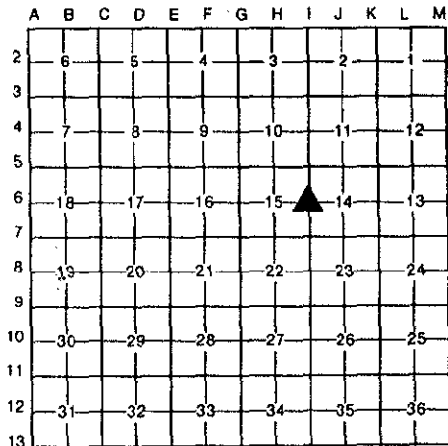

A. Description of original monument and accessories and/or subsequent restoration:

L.C.R.C. L. 1 P. 425 1972	L.C.R.C. L. 2 P. 711 1974
I-6 Found Stake & Brick (Midway on Line)	I-6 Fence Cor. post
Set Cast Iron Monument	Square wood post
18" Maple W 111.58'	St. sign post
18" Aspen SSW 183.80'	N end headwall
St. Sign NNW 18.75'	N end headwall
Centerline 112th E 10'	

B. Description of corner evidence found and/or method applied in restoring or reestablishing corner:


I-6 Found C.I. Mon. 0.03'S and 0.17'W of Midpoint	
Nail and Tag E. Side 20" Maple	WEST 111.38'
St. Sign	NNW 18.3'
Centerline 112th Avenue	EAST 10'
Nail in 10" Maple	SOUTH 71.10'

This marker is accepted as a careful and faithful perpetuation of the original corner.

C. Description of monument for corner and accessories established to perpetuate locating the position of the corner:

I-6 C.I. Mon. Centerline of 112th Avenue 10' East	
Set Nail & O.C. Remon Tag SE side Light Pole	N35°E 186.18'
Set Nail & O.C. Remon Tag NW side Power Pole	N10°E 206.86'
Set Nail & O.C. Remon Tag S side Power Pole	S87°W 25.32'
Set Nail & O.C. Remon Tag E side 10" Maple	S 5°W 70.87'

Signed by Douglas J. Koning
Surveyor's Michigan License No. 35995

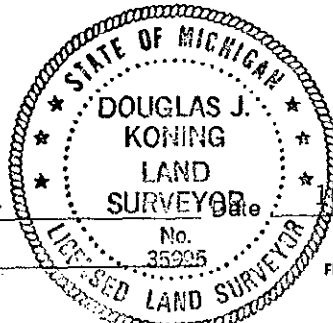

Date 10-19-93

FORM APPROVED BY MICHIGAN STATE BOARD OF LAND SURVEYORS, JAN. 28, 1971
REVISED MAY 14, 1975
REVISED JAN., 1993