

**SURVEY & REMONUMENTATION**

DEC 01 1993

OTTAWA COUNTY REMONUMENTATION  
**LAND CORNER RECORDATION CERTIFICATE**  
 Filing Requirement of Act 74, Mich. P.A. 1970

RECORDED

93 NOV 11 AM 11:55

COMMISSION  
 For corners in


*Richard A. Anderson*  
 REGISTER OF DEEDS  
 OTTAWA COUNTY, MI

<u>Ottawa</u> (County)	Located In:	Corner Code #/
1. Public Land Survey	T <u>6N</u> R <u>15W</u>	I-7
	T _____ R _____	(SE cor. Sec.
	T _____ R _____	<u>15, Olive Twp</u> )
	T _____ R _____	_____
2. Property Controlling in Section	S _____ T _____ R _____	_____
	S _____ T _____ R _____	_____
3. Miscellaneous Property in Sec.	S _____ T _____ R _____	_____
	S _____ T _____ R _____	_____
4. Lot No. _____, Recorded Plat _____		
5. Private Claims _____		

*Sequence #1*

Register of Deeds Stamp & File Number

I, Douglas J. Koning in a field survey on September 2, 19 93, do hereby certify that under requirements of P.A. 74, Michigan P.A. of 1970, the corner points mentioned in lines 1 and 2 above were in conformance with regulations and rules therefore as required in the current manual of survey instructions of the United States Department of the Interior, Bureau of Land Management or by a decree of a Court of Law and/or that the corner points mentioned in lines 3, 4 and 5 above were in conformance with the rules of the Michigan Board of Land Surveyors or by a Decree of a Court of Law; established, re-established, monumented, re-monumented, recovered, found as expressed below:

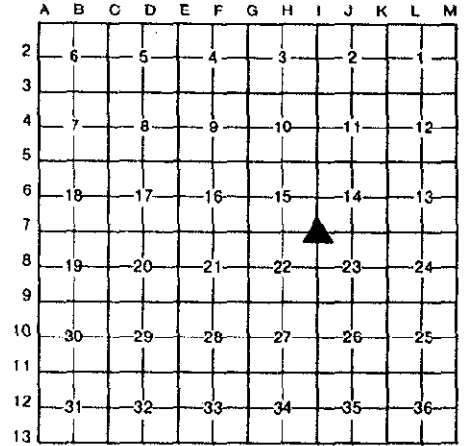

**NOTE: Not more than 4 corners, all in the same town and range, may be recorded on this certificate.**

A. Description of original monument and accessories and/or subsequent restoration:

L.C.R.C. L. 1 P. 69 1971	L.C.R.C. L. 2 P. 711 1974
I-7 Nail in face of 30" Maple SE 34.83'	I-7 SW cor. bridge headwall S30°W 19.52'
Nail in face of St. Sign NW 34.51'	NW cor. bridge headwall N35°W 17.38'
Nail in face of Power Pole NW 74.59'	SE cor. bridge headwall S25°E 19.00'
Nail in face of Tel. Pole SW 42.32'	NE cor. bridge headwall N25°E 16.39'
Nail in face of Triple Sycamore NW 108.76'	

B. Description of corner evidence found and/or method applied in restoring or reestablishing corner:


I-7 Found C.I. Mon. in Mon. Box  
 Nail in face of Triple Sycamore NW 108.67'

This marker is accepted as a careful and faithful perpetuation of the original corner.

C. Description of monument for corner and accessories established to perpetuate locating the position of the corner:

I-7 C.I. Mon in Box (Centerline of cross roads N, S, E, W)	
Nail and O.C. Remon Tag West side Triple Sycamore	N14°W 110.65'
Nail and O.C. Remon Tag NE side Power Pole	N56°W 75.10'
Nail and O.C. Remon Tag SE side 12" Pine	S41°W 57.22'
Nail and O.C. Remon Tag SW side 54" Maple	S52°E 36.58'

Signed by *Douglas J. Koning*  
 Surveyor's Michigan License No. 35995

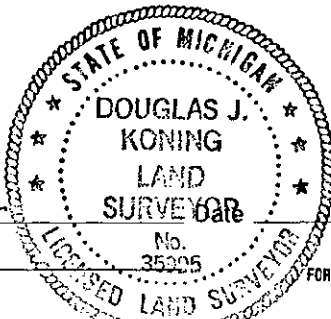

10-19-93

FORM APPROVED BY MICHIGAN STATE BOARD OF LAND SURVEYORS, JAN. 28, 1971  
 REVISED MAY 14, 1975  
 REVISED JAN., 1993