

**OTTAWA COUNTY REMONUMENTATION
LAND CORNER RECORDATION CERTIFICATE**

RECORDED

96 DEC 17 AM 10:41

For corners in

Filing Requirement of Act 74, Mich. P.A. 1970

Richard Ballman
REGISTER OF DEEDS
OTTAWA COUNTY, MI

<u>Ottawa</u> (County)	Located in:	Corner Code #
1. Public Land Survey	T 6N R15W	I-10
	T R	(E 1/4 cor., Sec. 27
	T R	Olive Twp.)
	T R	
2. Property Controlling In Section	S T R	
	S T R	
3. Miscellaneous Property in Sec.	S T R	
	S T R	
4. Lot No. _____, Recorded Plat _____		
5. Private Claims _____		

Register of Deeds Stamp & File Number

	A	B	C	D	E	F	G	H	I	J	K	L	M
2	6	5	4	3	2	1							
3													
4	7	8	9	10	11	12							
5													
6	18	17	16	15	14	13							
7													
8	19	20	21	22	23	24							
9													
10	30	29	28	27	▲ 26	25							
11													
12	31	32	33	34	35	36							
13													

I, Douglas J. Koning, in a field survey on November 8, 1996, do hereby certify that under requirements of P.A. 74, Michigan P.A. of 1970, the corner points mentioned in lines 1 and 2 above were in conformance with regulations and rules therefore as required in the current manual of survey instructions of the United States Department of the Interior, Bureau of Land Management or by a decree of a Court of Law and/or that the corner points mentioned in lines 3, 4 and 5 above were in conformance with the rules of the Michigan Board of Land Surveyors or by a Decree of a Court of Law; established, re-established, monumented, re-monumented, recovered, found as expressed below:

NOTE: Not more than 4 corners, all in the same town and range, may be recorded on this certificate.

- A. Description of original monument and accessories and/of subsequent restoration:
- | | | |
|----------------------------|-----------------------------|---------------|
| I-10 Government Notes | L.C.R.C. Liber 3, Page 214 | November 1979 |
| Set Post May 1832 | I-10 Set Cast Iron Monument | |
| By Calvin Britain D.S. | 20" Maple | SSW 70.82' |
| Tamarack 8" N60°E 44 Links | Guy Pole | NW 39.7' |
| Leo 6" S33°E 52 Links | Power Pole | NE 38.9' |

P.A. 345 OTTAWA COUNTY
PEER APPROVED 11-11-96

D.J.K.

- B. Description of corner evidence found and/or method applied in restoring or reestablishing corner.


I-10 Found Cast Iron Monument 24" Deep
Found Tag & Nail in NE side Guy Pole NW 39.68'
Found Nail SE side Power Pole NE 38.86'

This marker is accepted as a careful and faithful perpetuation of the original corner.

- C. Description of monument for corner and accessories established to perpetuate locating the position of the corner.

I-10 Set 3/4" Form Pin & Remon cap (in Mon. box) above Cast Iron Monument
Set Remon Tag & Nail in NW side Power Pole S49°W 81.17'
Set Remon Tag & Nail in NE side Guy Pole N41°W 39.58'
Set Remon Tag & Nail in Sly Side Power Pole N56°E 38.64'
Set Remon Tag & Nail in N end 36" CMP Culvert N63°W 55.93'
In Centerline "X" of Roads

\$ 9.00 CORNER
\$ 1.00 PHOTO

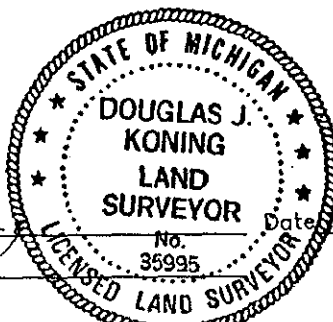

Signed by Douglas J. Koning Date 11-11-96
Surveyor's Michigan License No. 35995